

SECTION

13

14

23

24

Per 13806
13792


TOWNSHIP 12 S, RANGE 18 E, W. M.

North

1/4 Cor.

West

East

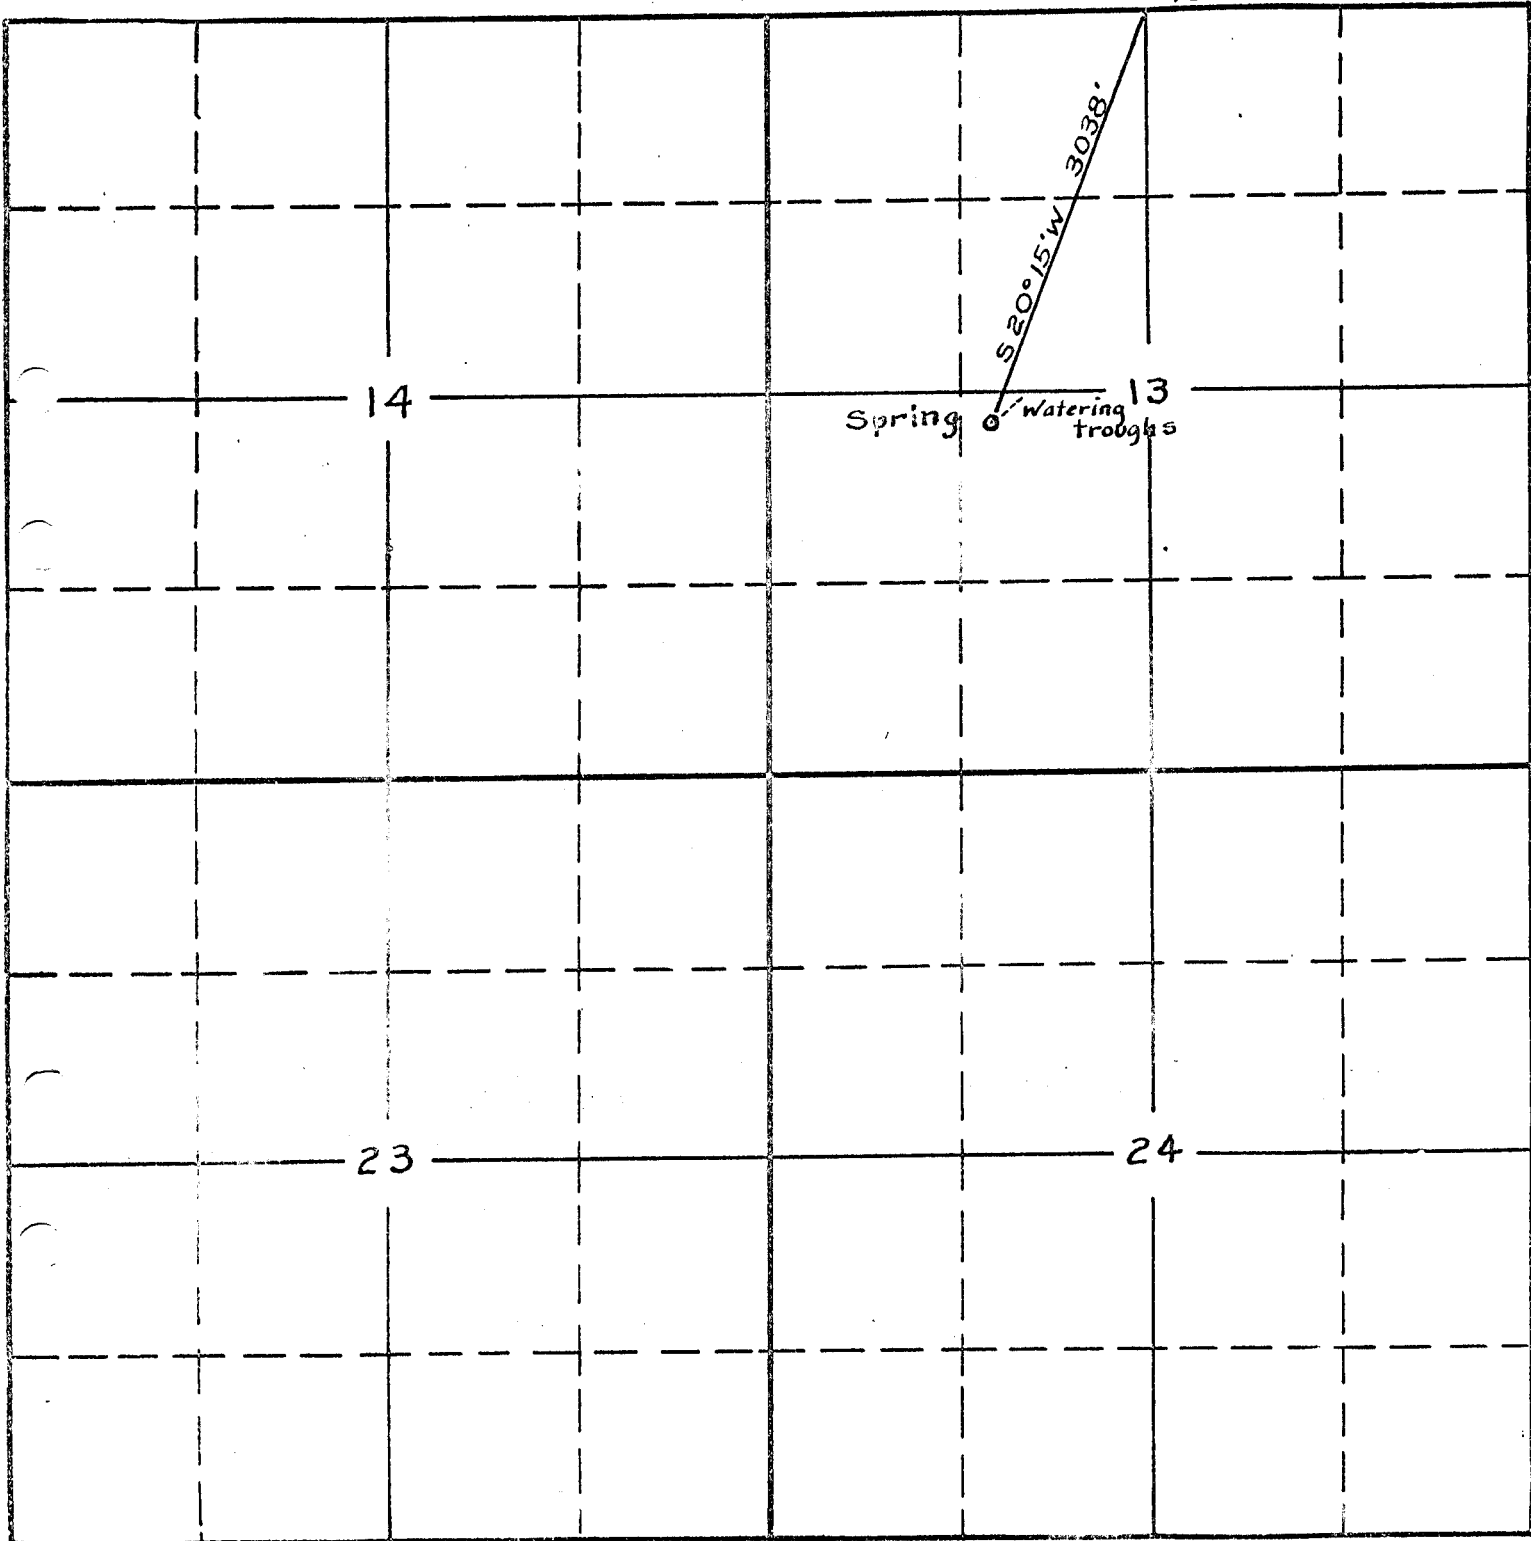

South

RECEIVED

JUN 16 1939

STATE ENGINEER
SALEM, OREGON

RECEIVED

JUN 22 1939

STATE ENGINEER
SALEM, OREGON

APPLICATION No. 18170
PERMIT No. 13806