


Notes

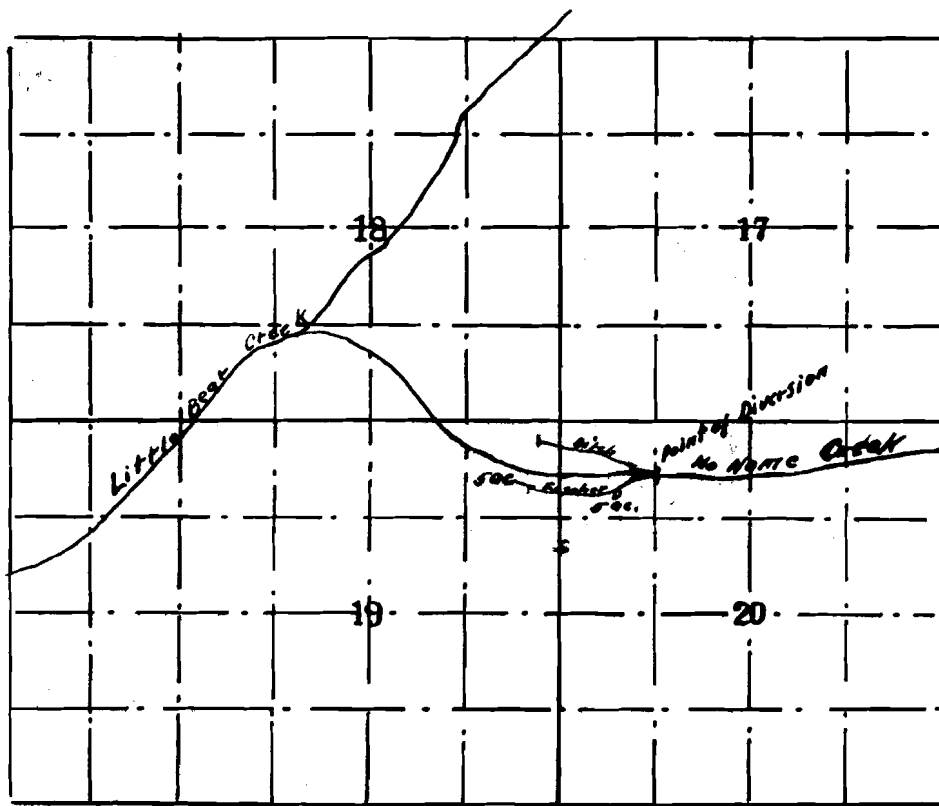

This map was made from notes taken by Carl Fischer the applicant, and correctly represents the works described in the accompanying application.

Map of CARL FISCHER DITCH

CROOK COUNTY ORE.

Scale 2" = 1 Mile

T. 18S. R. 19E.

FILE OF STATE

RECEIVED

AUG 25 1914

SALEM, OREGON,

Application No.

Permit No.

3889
2180

3889

2180

21381