



T28S R14W WM.

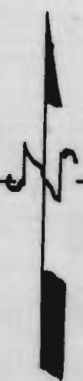

MANUEL WILSON & MARTHA NIELSON


SE⁴ - NE⁴

CENTER OF
16
SECTION

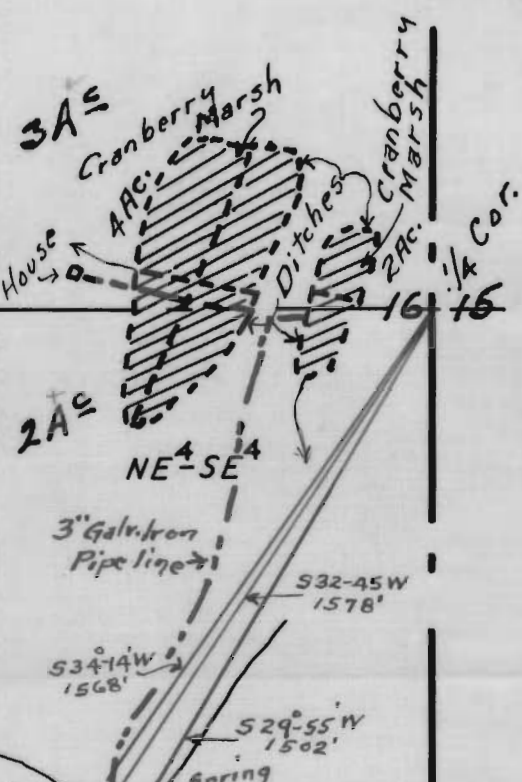

Dam-9' high
2 Rows of Piling &
driven sheeting-filled
with earth-
Electric pump to be
installed- water
to be pumped.
Lift 80'- Bogs are
60' above Dam

THOS. H. ROSE

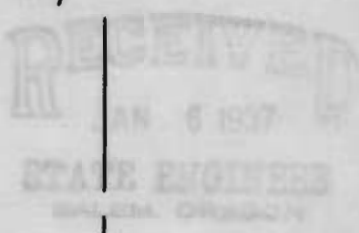

SCALE - 1" = 500'

JAN. - 1937.

Application No. 16740

Permit No. 12527

17-19-16740 - OR