


See application map
for diversion points

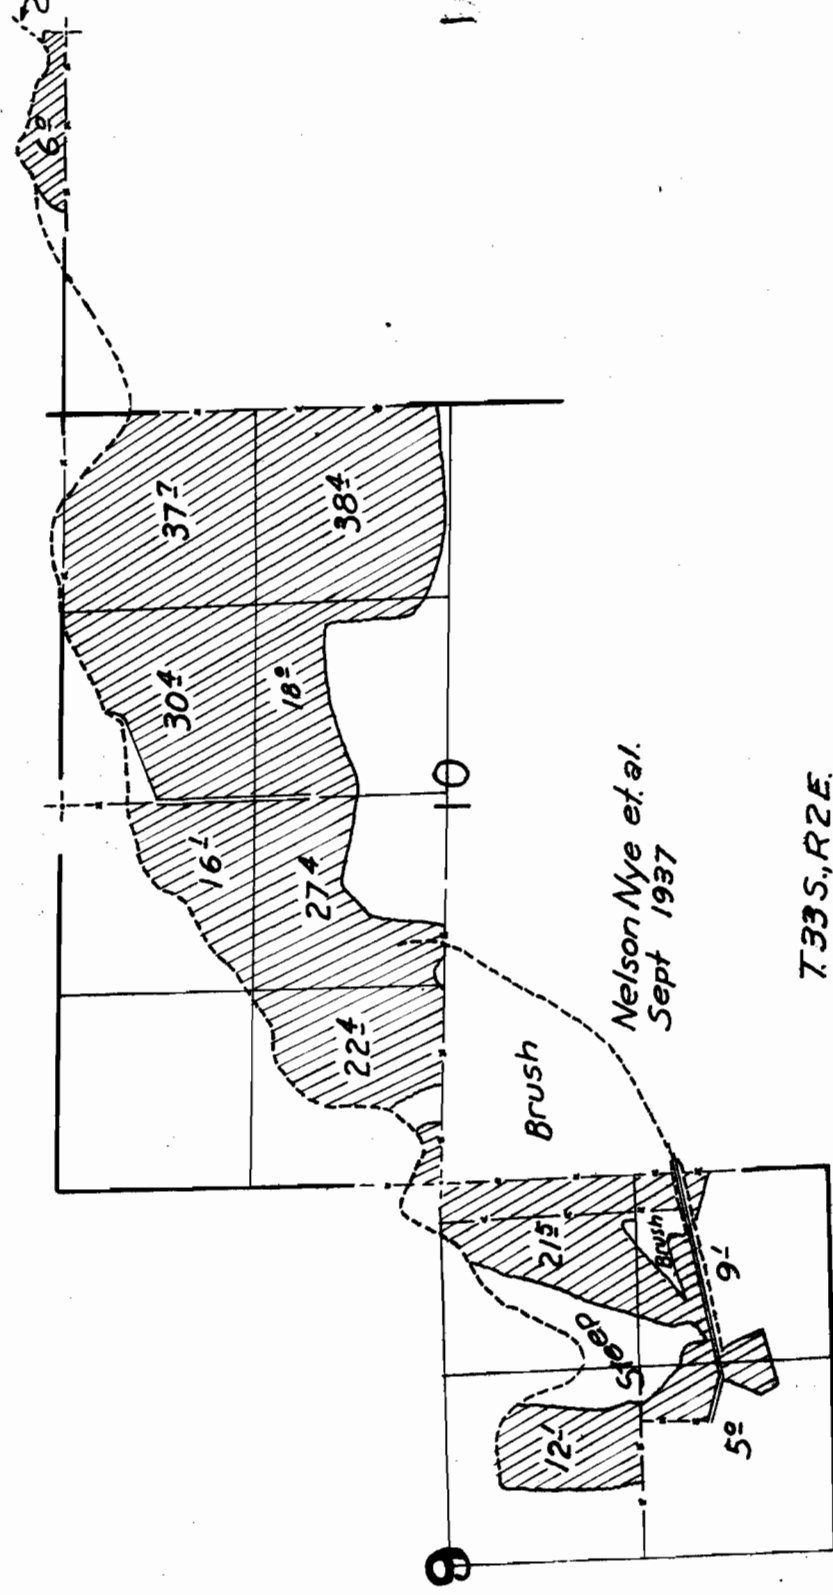

Application 13892
 Permit 10448
 (Survey by C. Cummings)

T.33S., R.2E.