


TOWNSHIP 55, RANGE 3W, W. M.

North

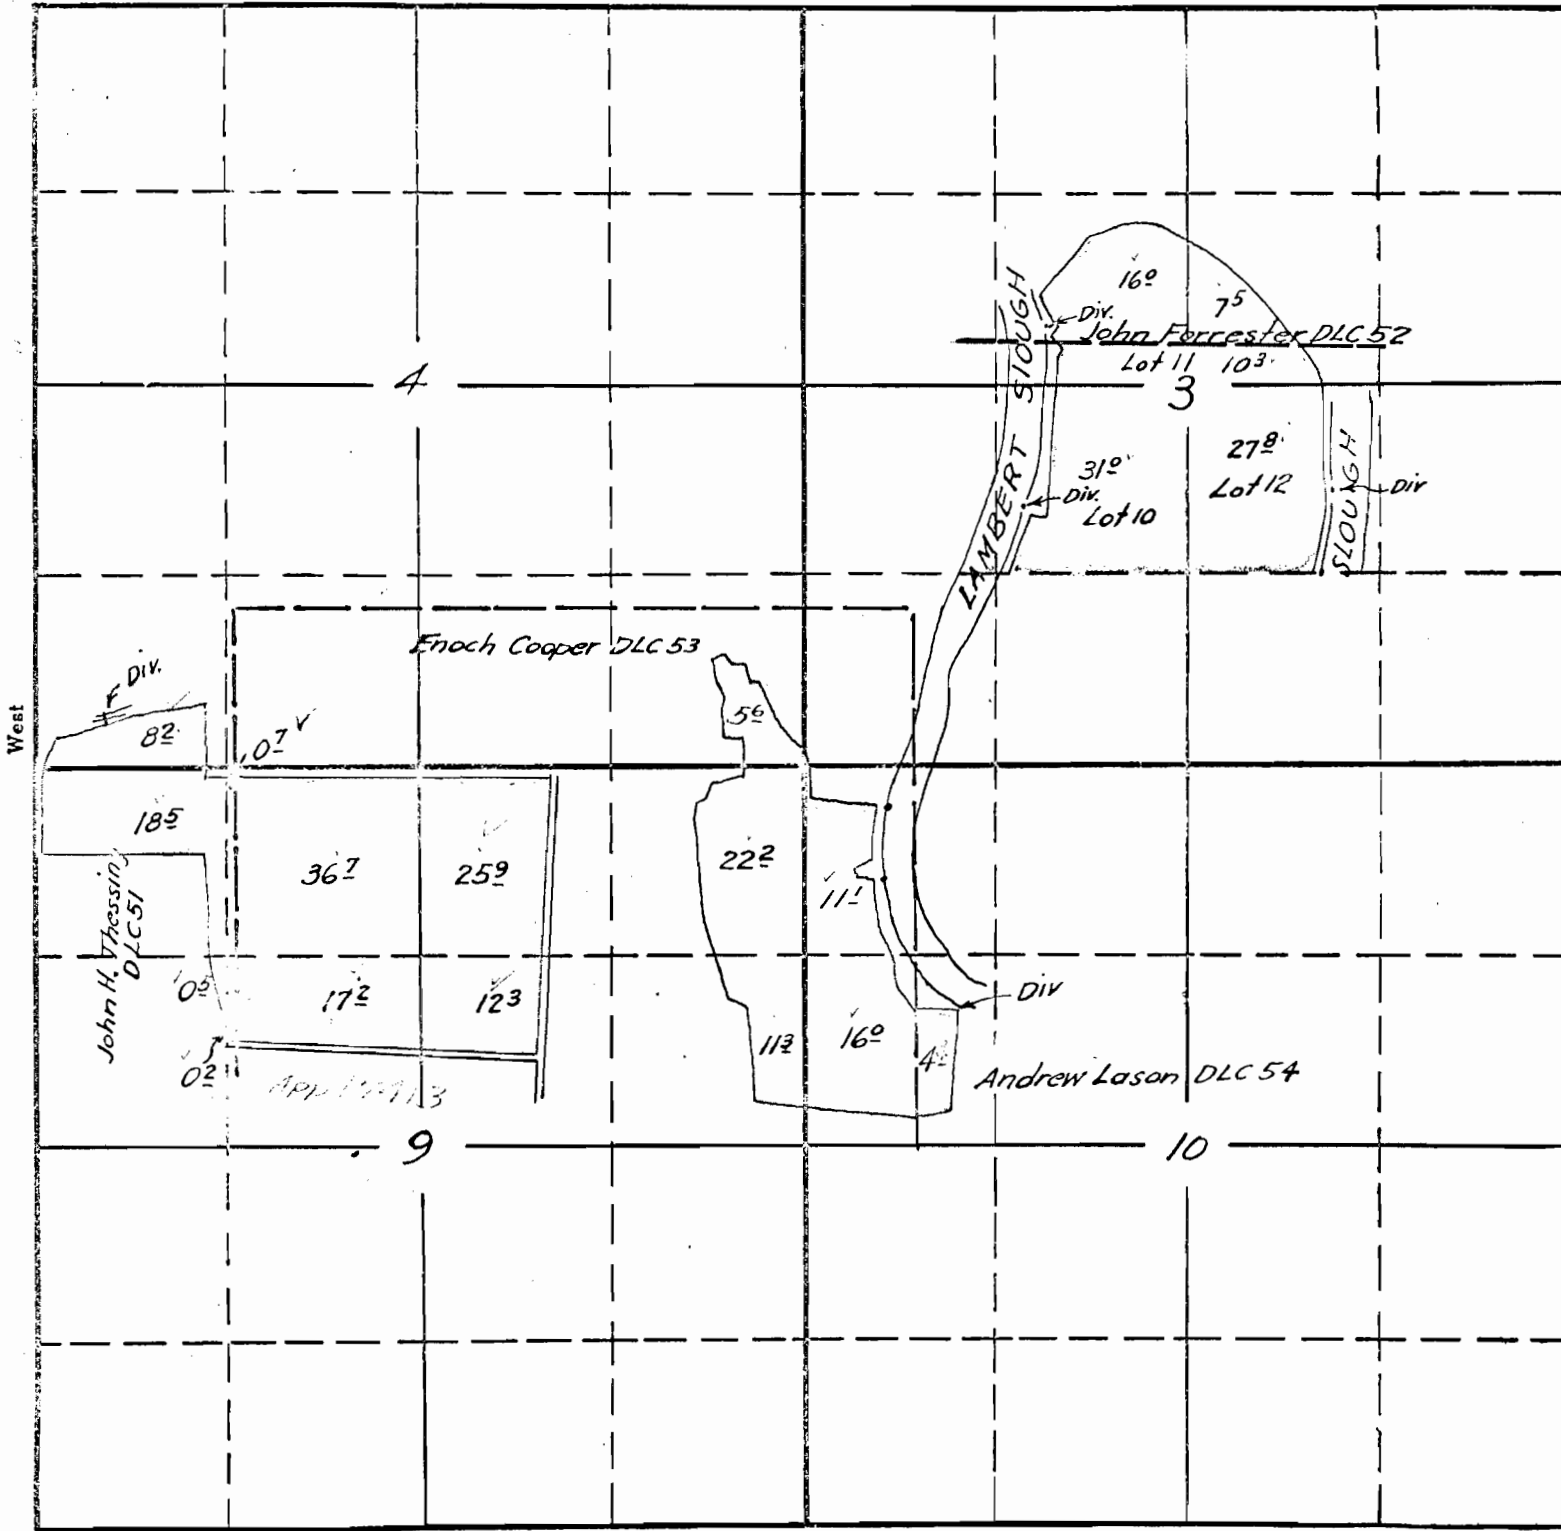

West

South

Surveyor: May 1 1941 C.A.C.

APPLICATION No. 17213

PERMIT No. 13847

13110

See Corrected map  
for land in Section 3