


SECTION

1

TOWNSHIP 55 , RANGE 46E , W. M.

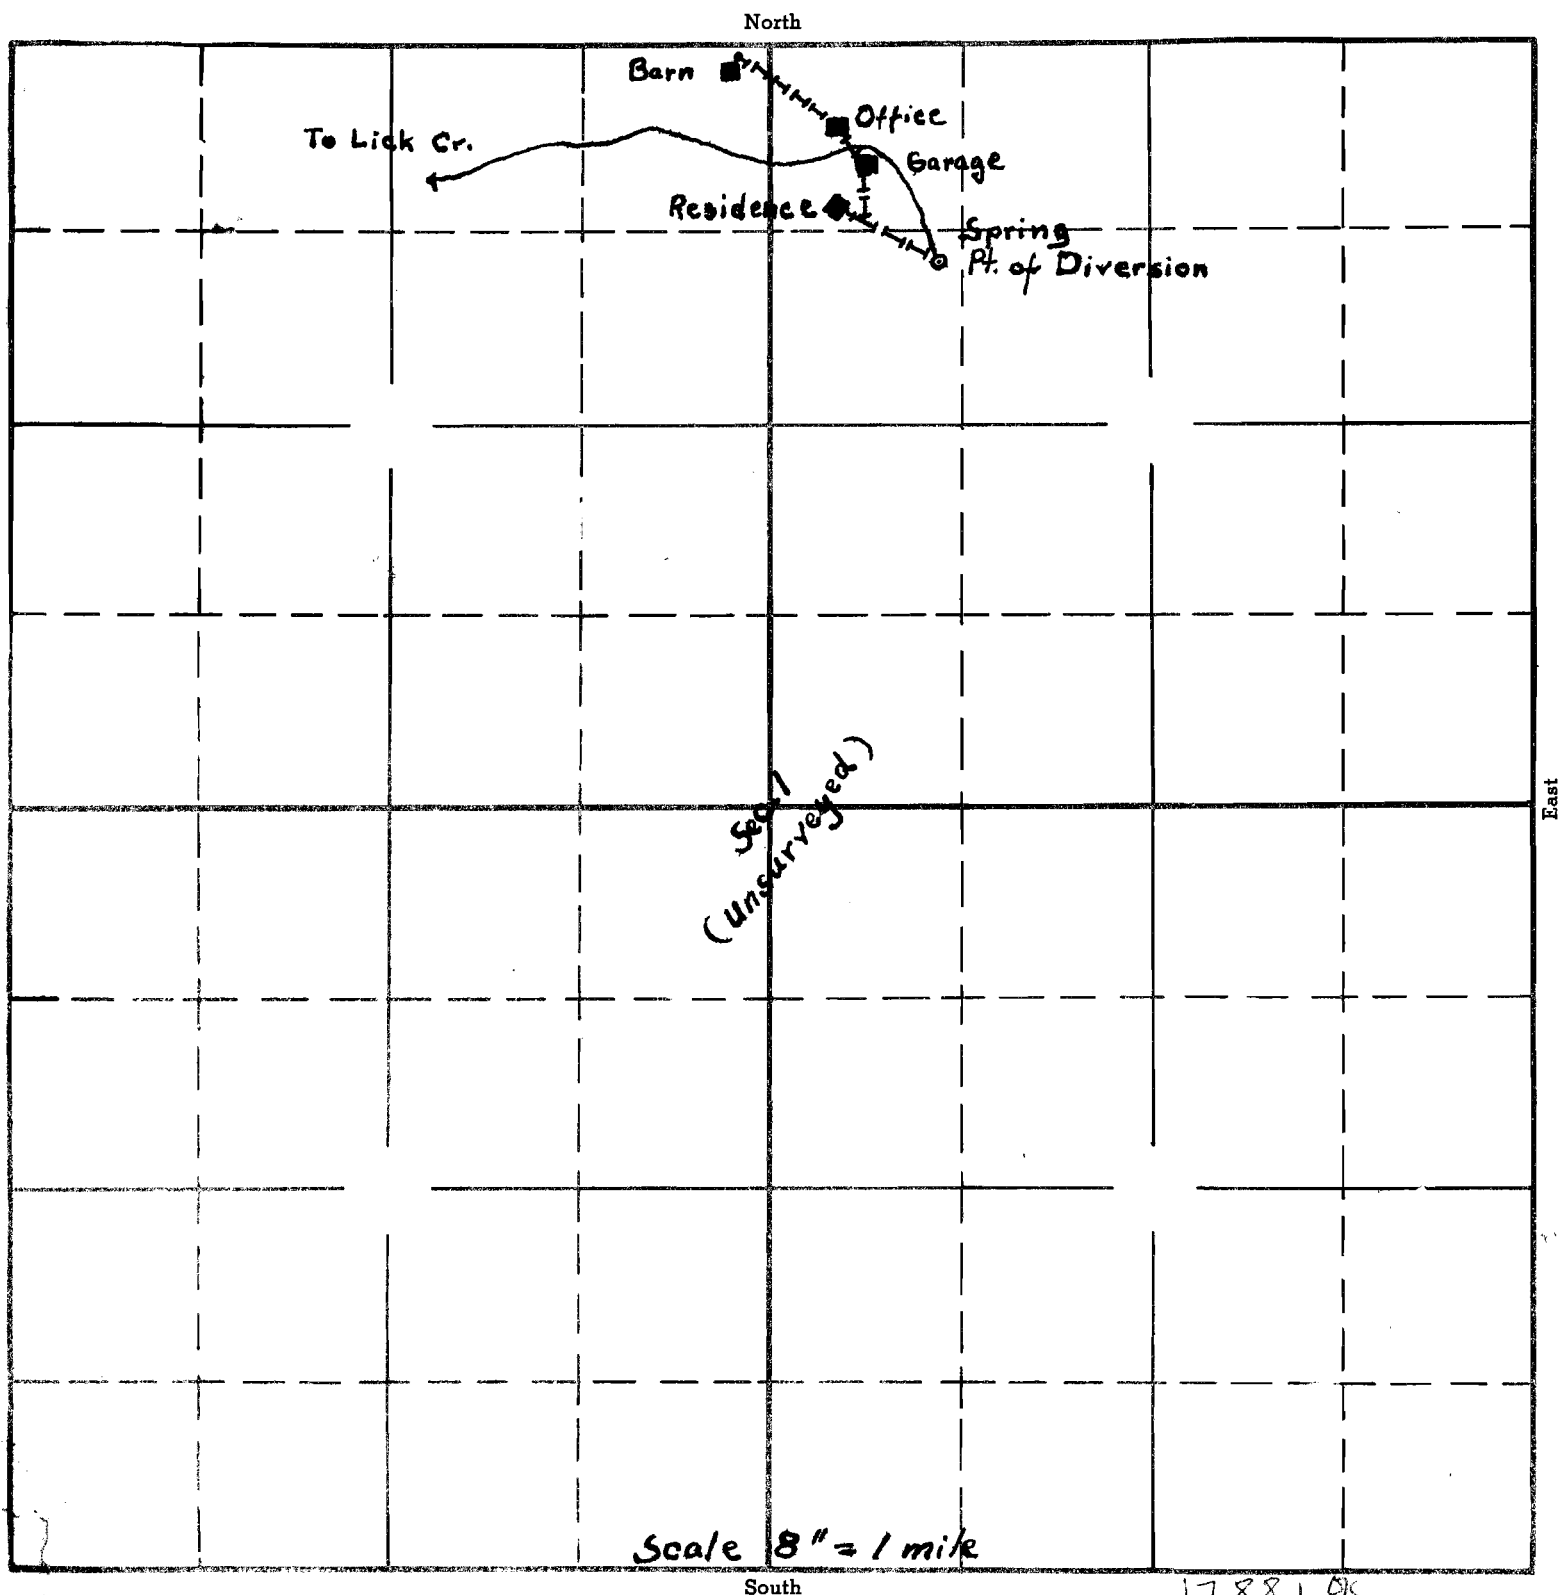

RECEIVED

APR 6 1939

STATE ENGINEER
SALEM, OREGON

17881 OK
8-26
APPLICATION No. 17881
PERMIT No. 13554