

SECTION


20821

D. 13826

13997

TOWNSHIP 55, RANGE 28E, W. M.

North

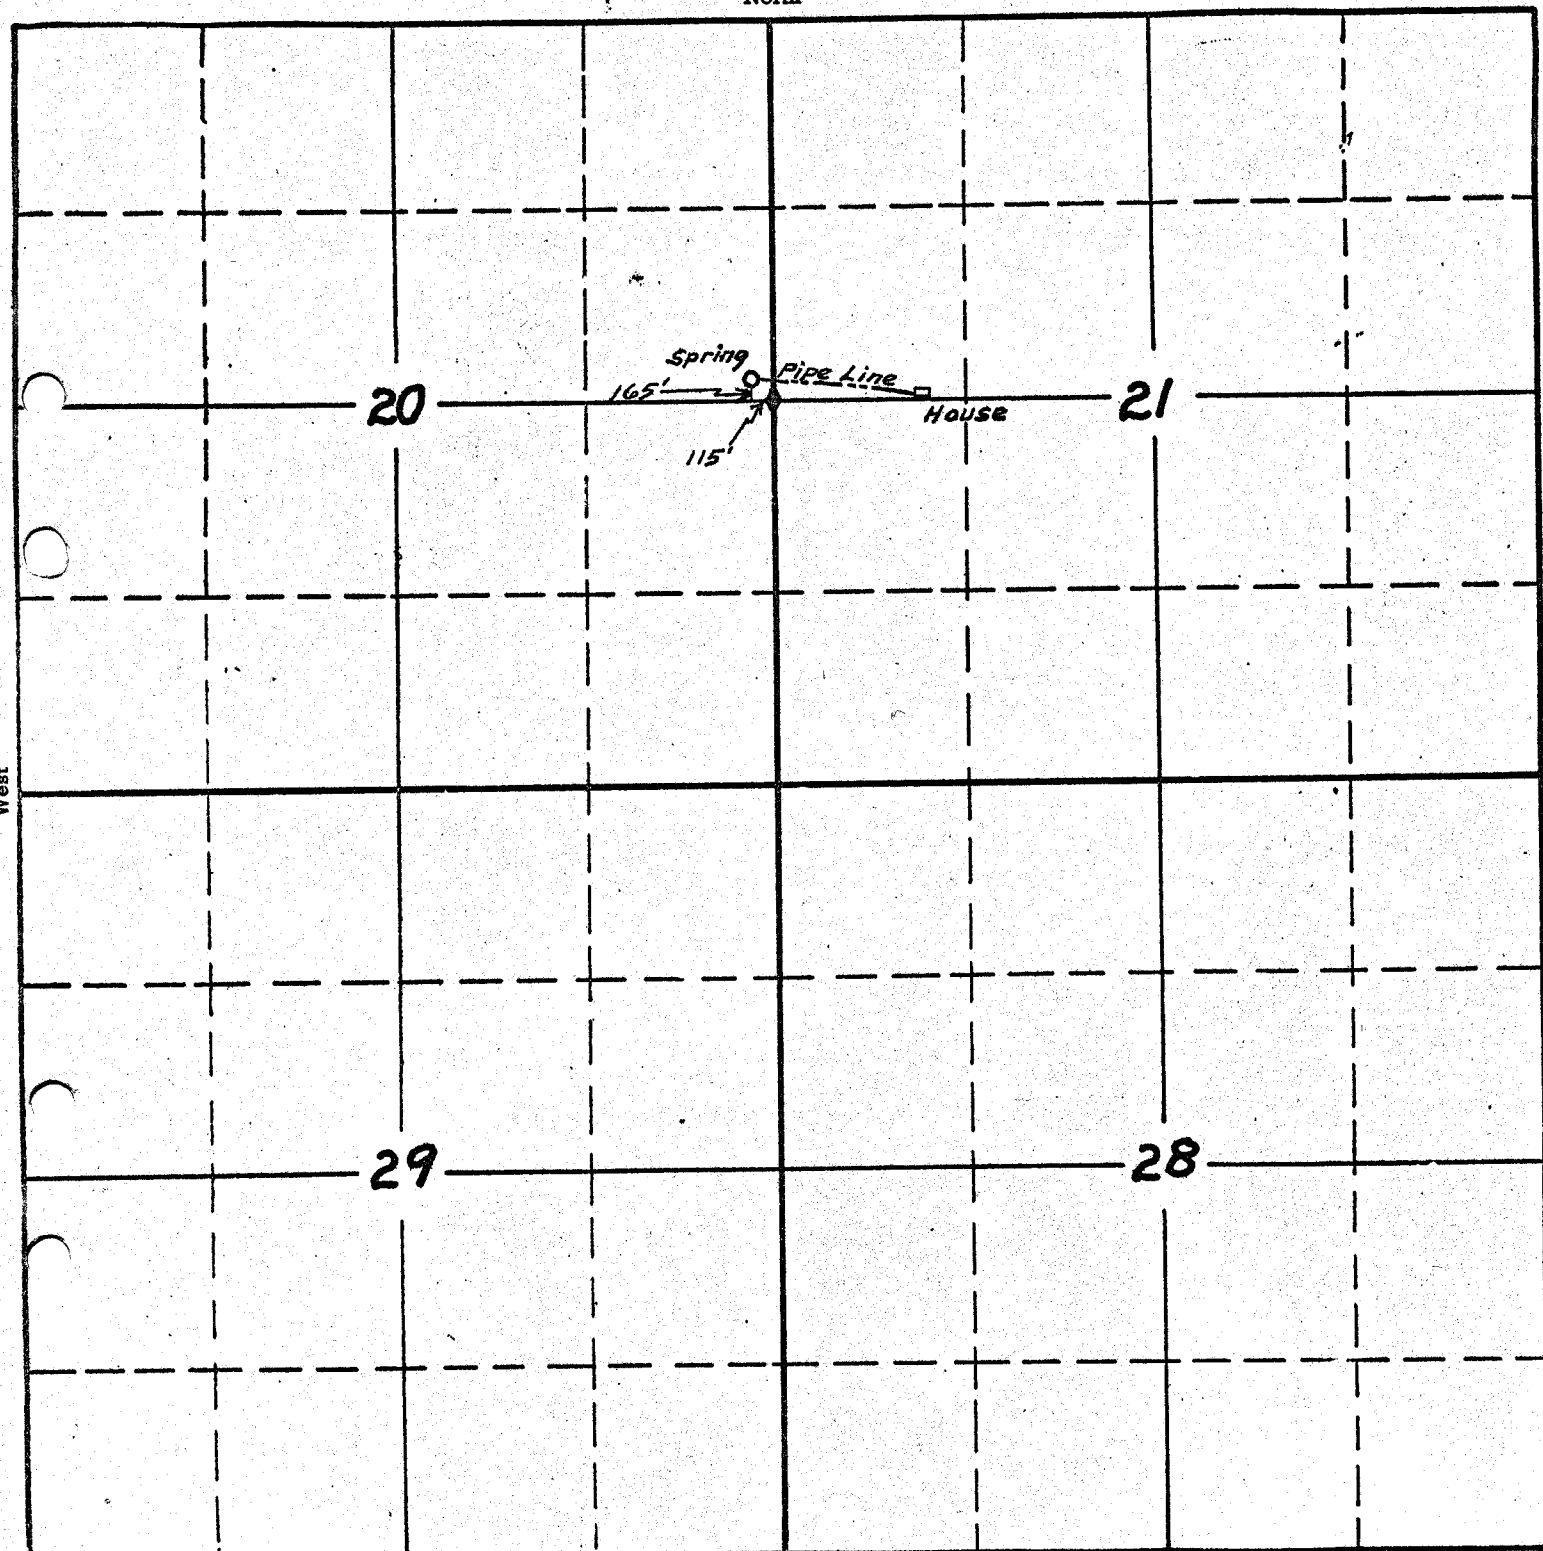

West

East

South

Scale 4" = 1 mile

18202 OK

6-29

APPLICATION No. 18202

PERMIT No. 13826