


- SECTION

7

P. 13827

13998

TOWNSHIP 7S, RANGE 26E, W. M.

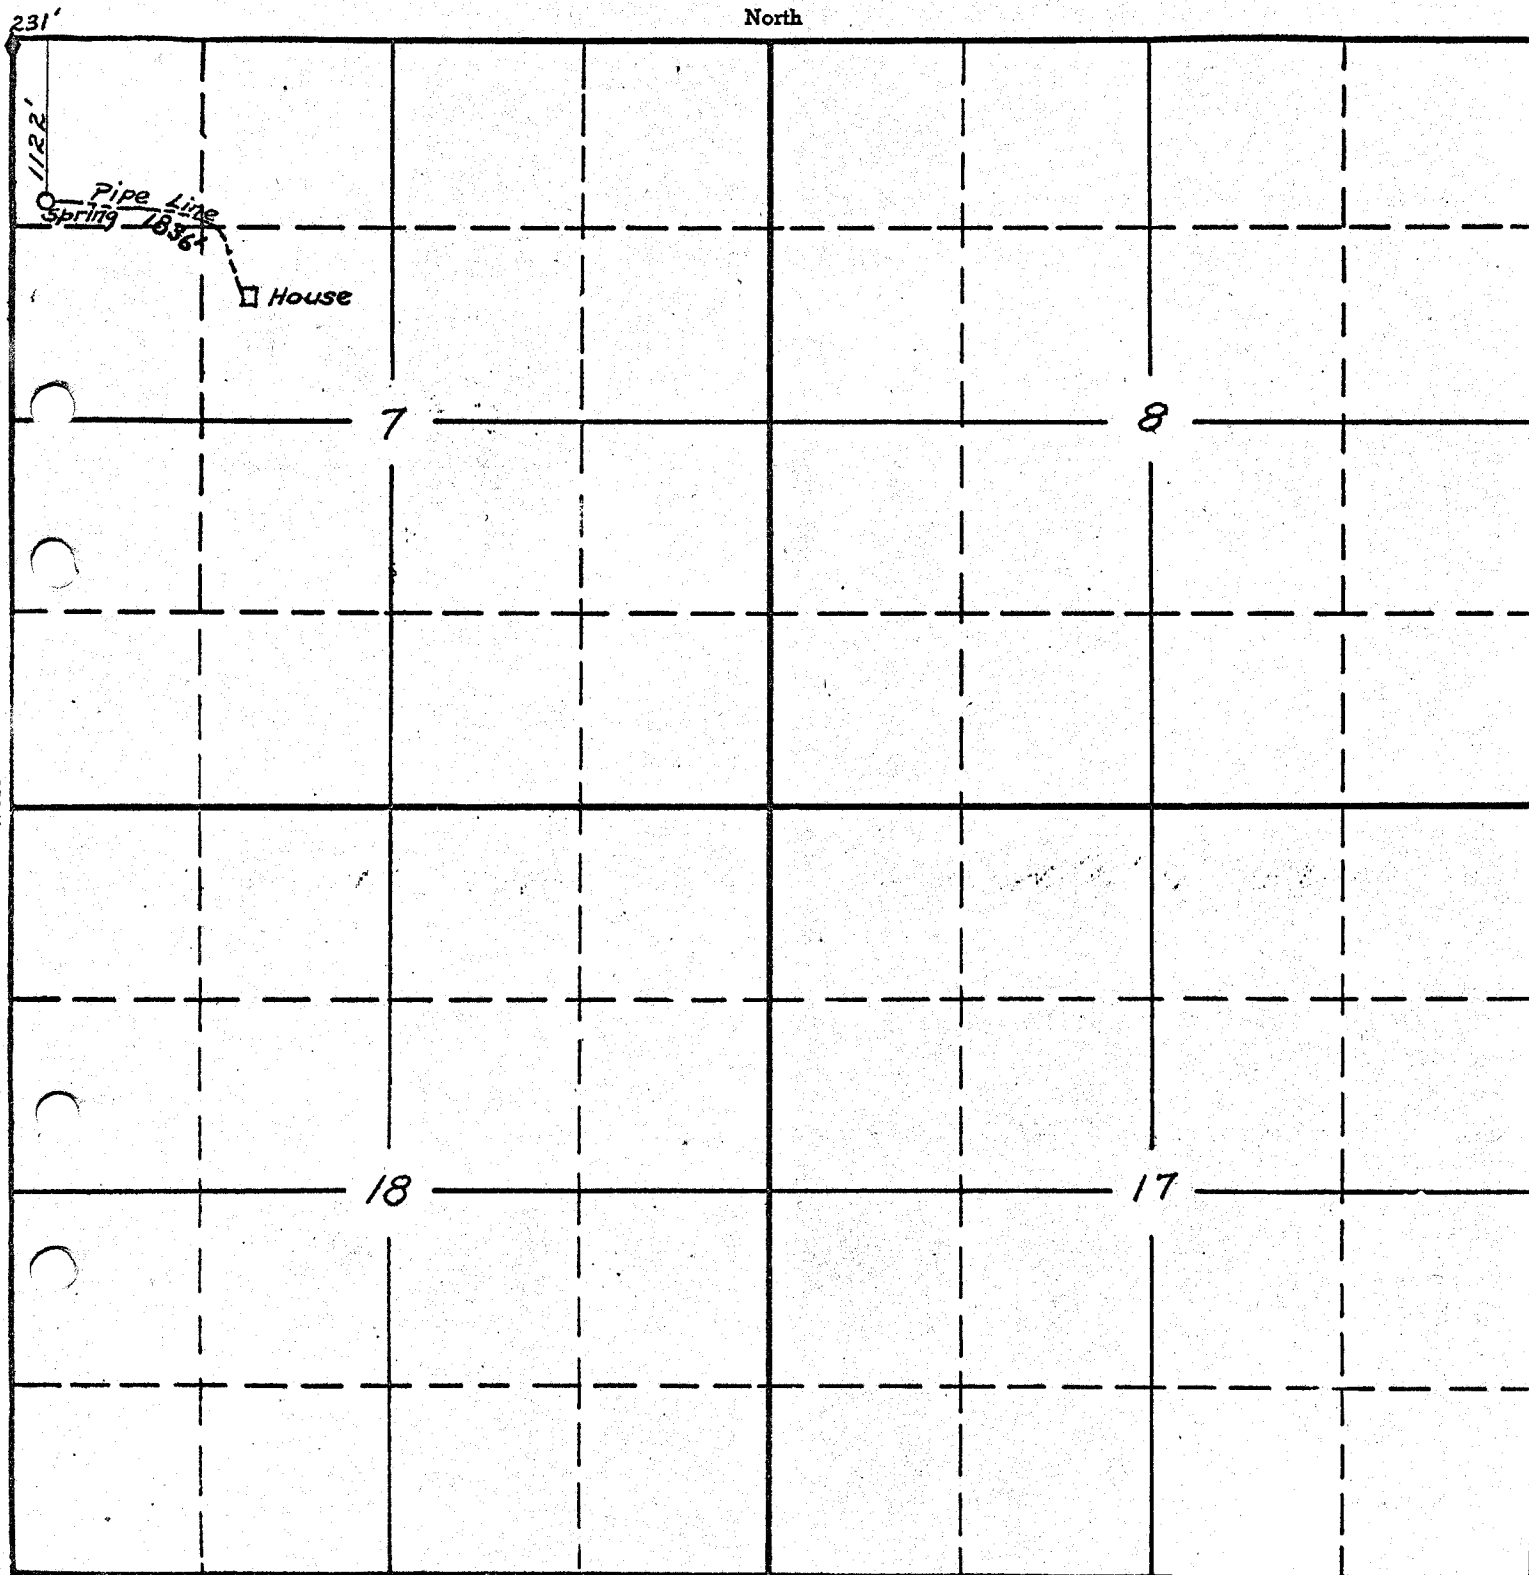

Scale 4" = 1 mile

South

18203 or
6-29
APPLICATION No. 18203
PERMIT No. 13827