


North

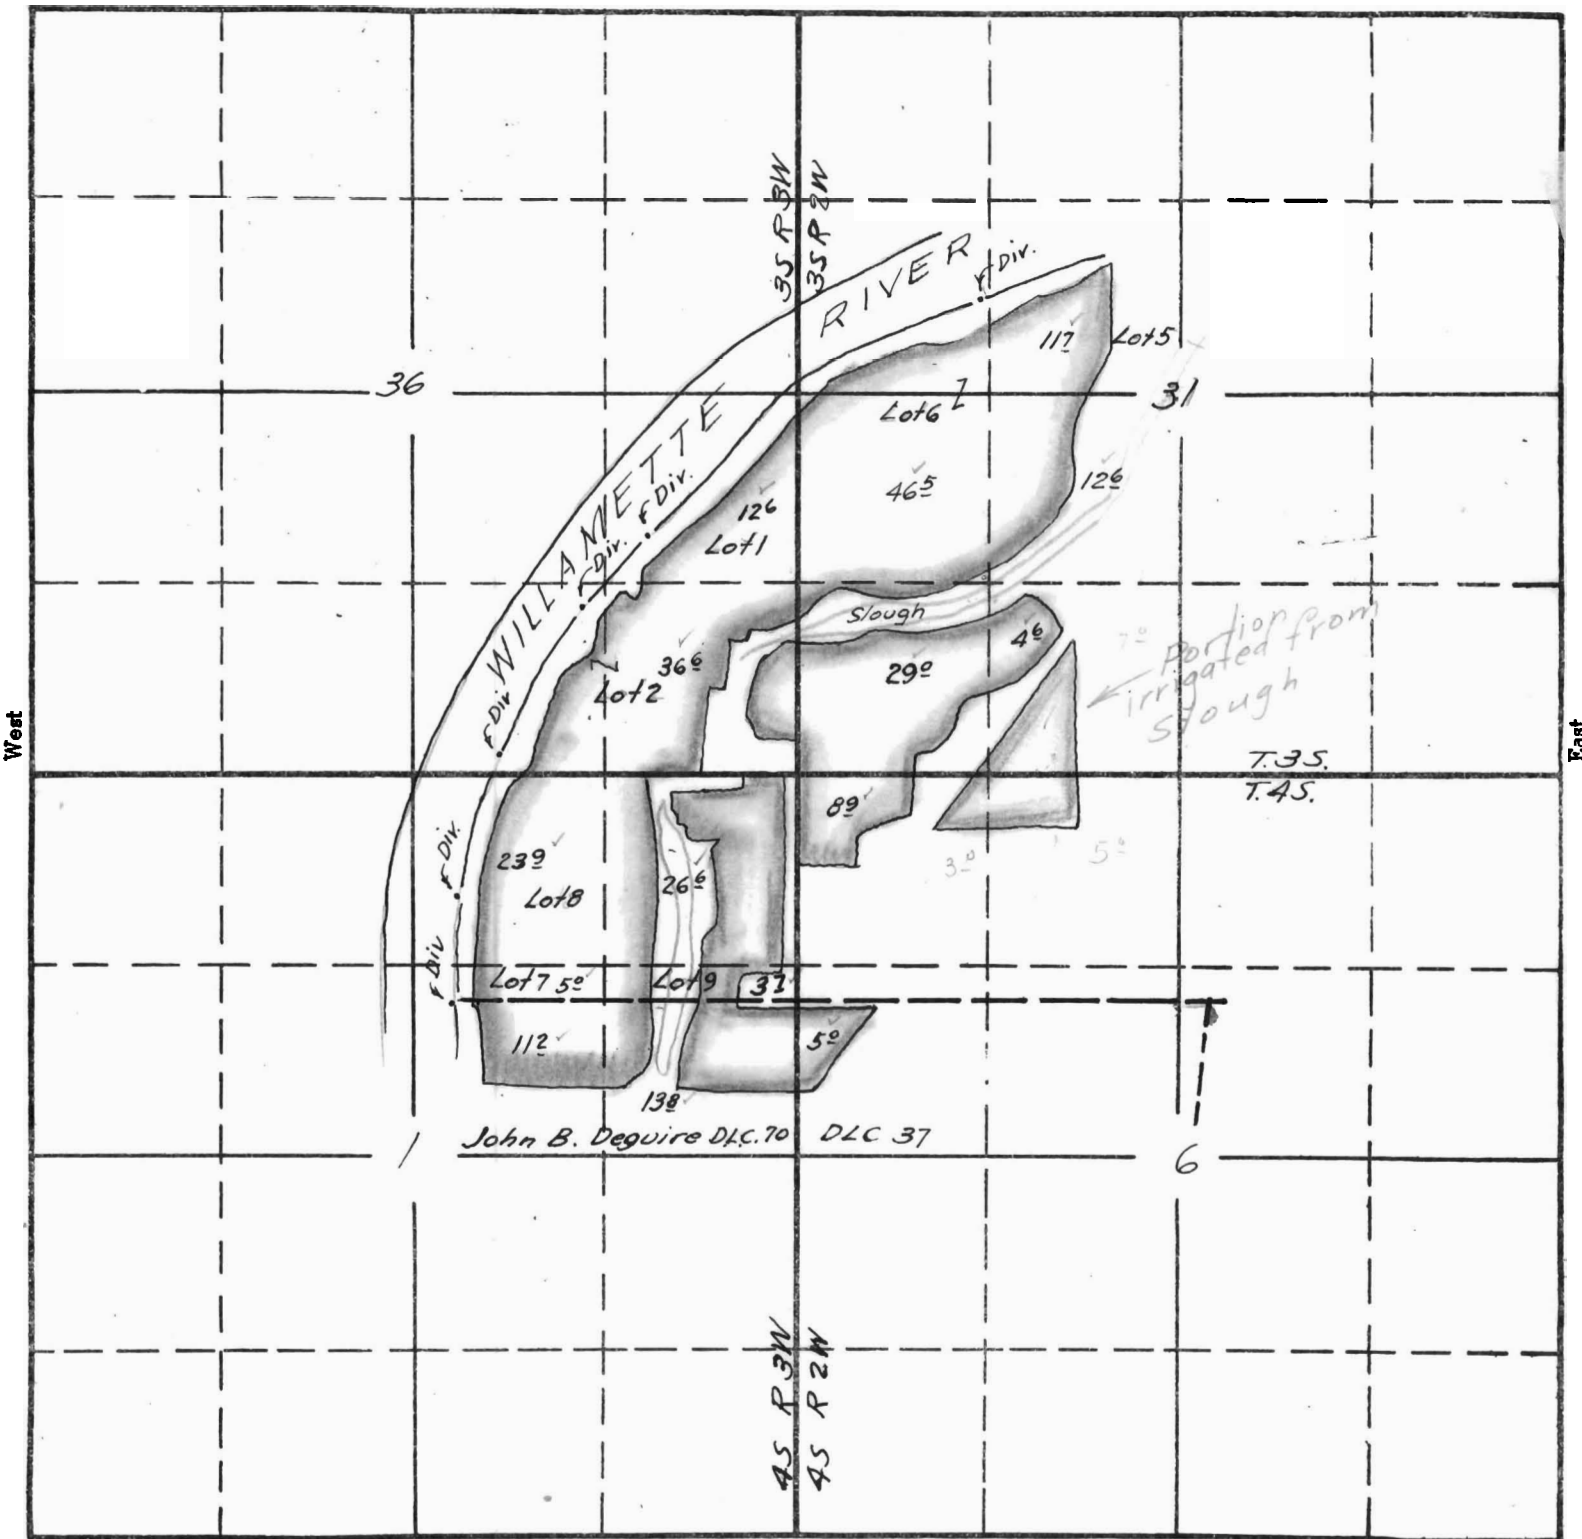

West

East

South

Surveyed May 3 1941 C.C.B.

APPLICATION No. 18241

PERMIT No. 13999