


T.25S. R.13W. W.M.

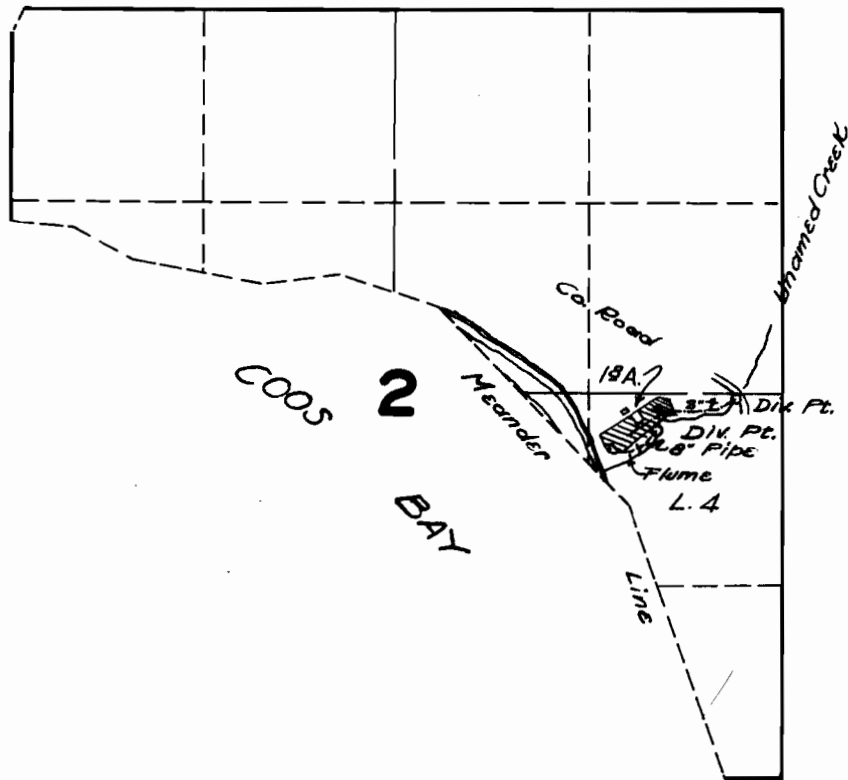

**FINAL PROOF SURVEY**

UNDER

Application No. 18351..... Permit No. 13977....

IN NAME OF

.....JOHN GUENTHER.....

Surveyed AUG. 22 1949., by H.L. COFFMAN.