


SE $\frac{1}{4}$, SE $\frac{1}{4}$, SEC 35

I, AN GOULD OF COQUILLE OREG,
DO HEREBY CERTIFY, THAT THIS
MAP WAS MADE FROM NOTES
TAKEN IN THE FIELD DURING
AN ACTUAL SURVEY MADE BY ME
ON AUGUST 5TH, 1920, AND THAT IT
CORRECTLY REPRESENTS THE WORKS
DESCRIBED IN THE ACCOMPANYING
APPLICATION, TOGETHER WITH
WITH THE LOCATION OF THE
STREAMS IN THE VICINITY


A. M. Gould
REGISTERED PROFESSIONAL ENGINEER

OREGON #1127

JAN. 1ST, 1920

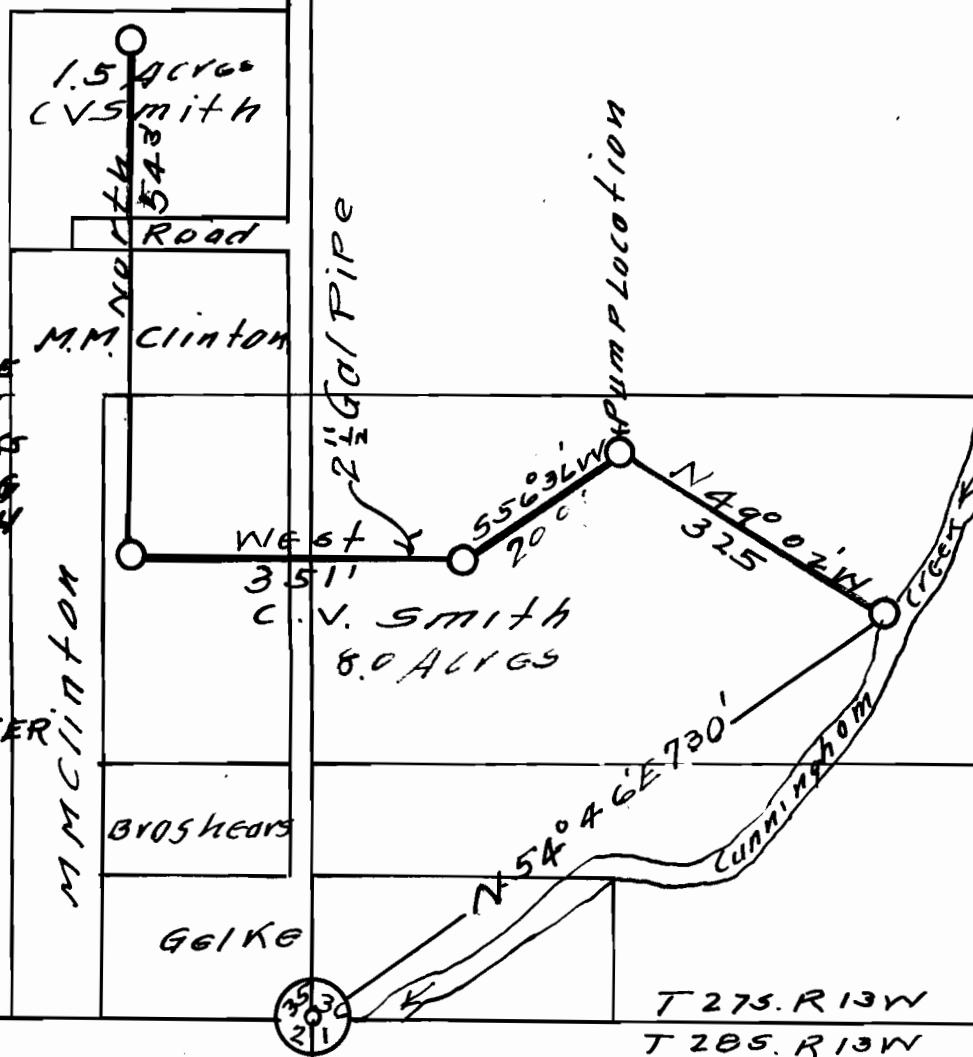

SW $\frac{1}{4}$, SW $\frac{1}{4}$, SEC 36

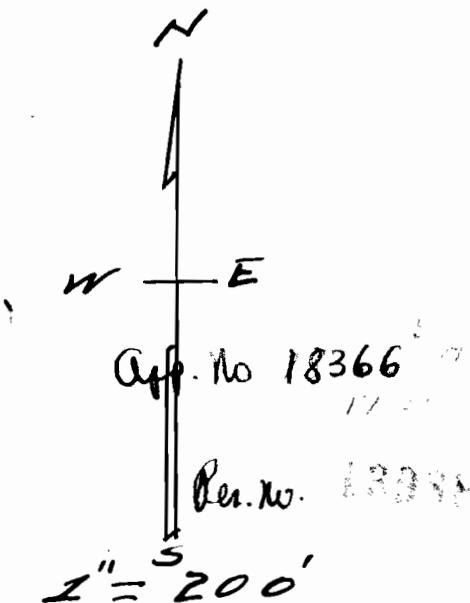

A. M. Gould