


R-761
14085

TOWNSHIP 38S. RANGE 11½ E.

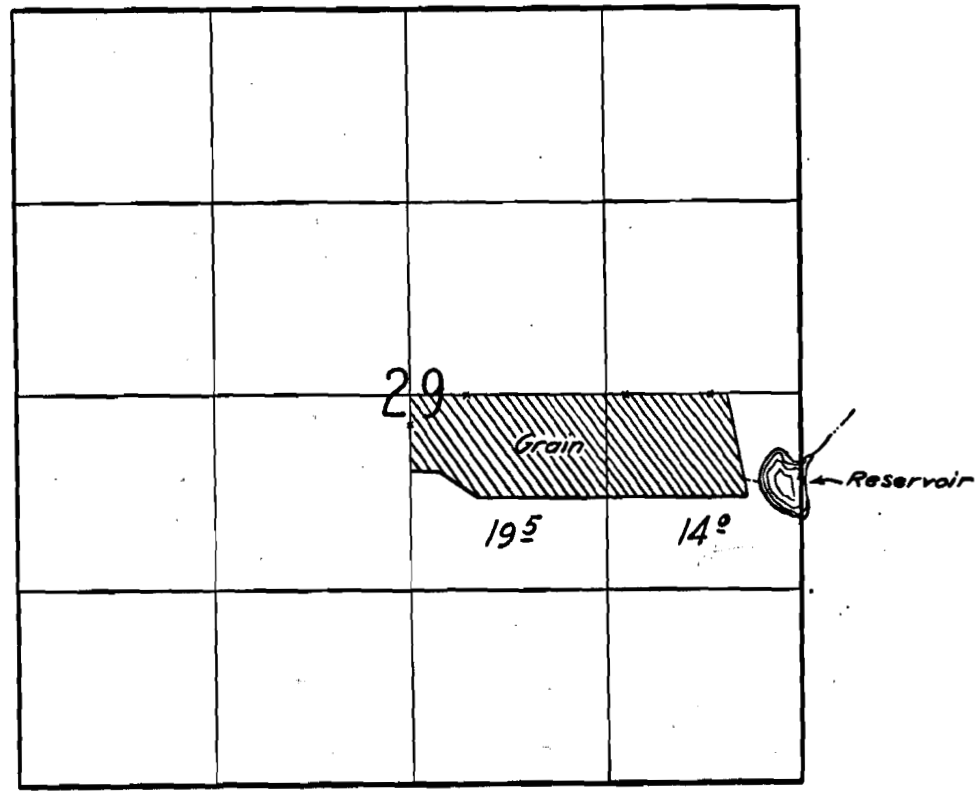

Swan Lake : Meas.

FINAL PROOF SURVEY

UNDER

R-19146

R-761

Application No. 19109 Permit No. 14714

IN NAME OF

Guy Barton

Surveyed 20 July 1941, by *Charles [unclear]*