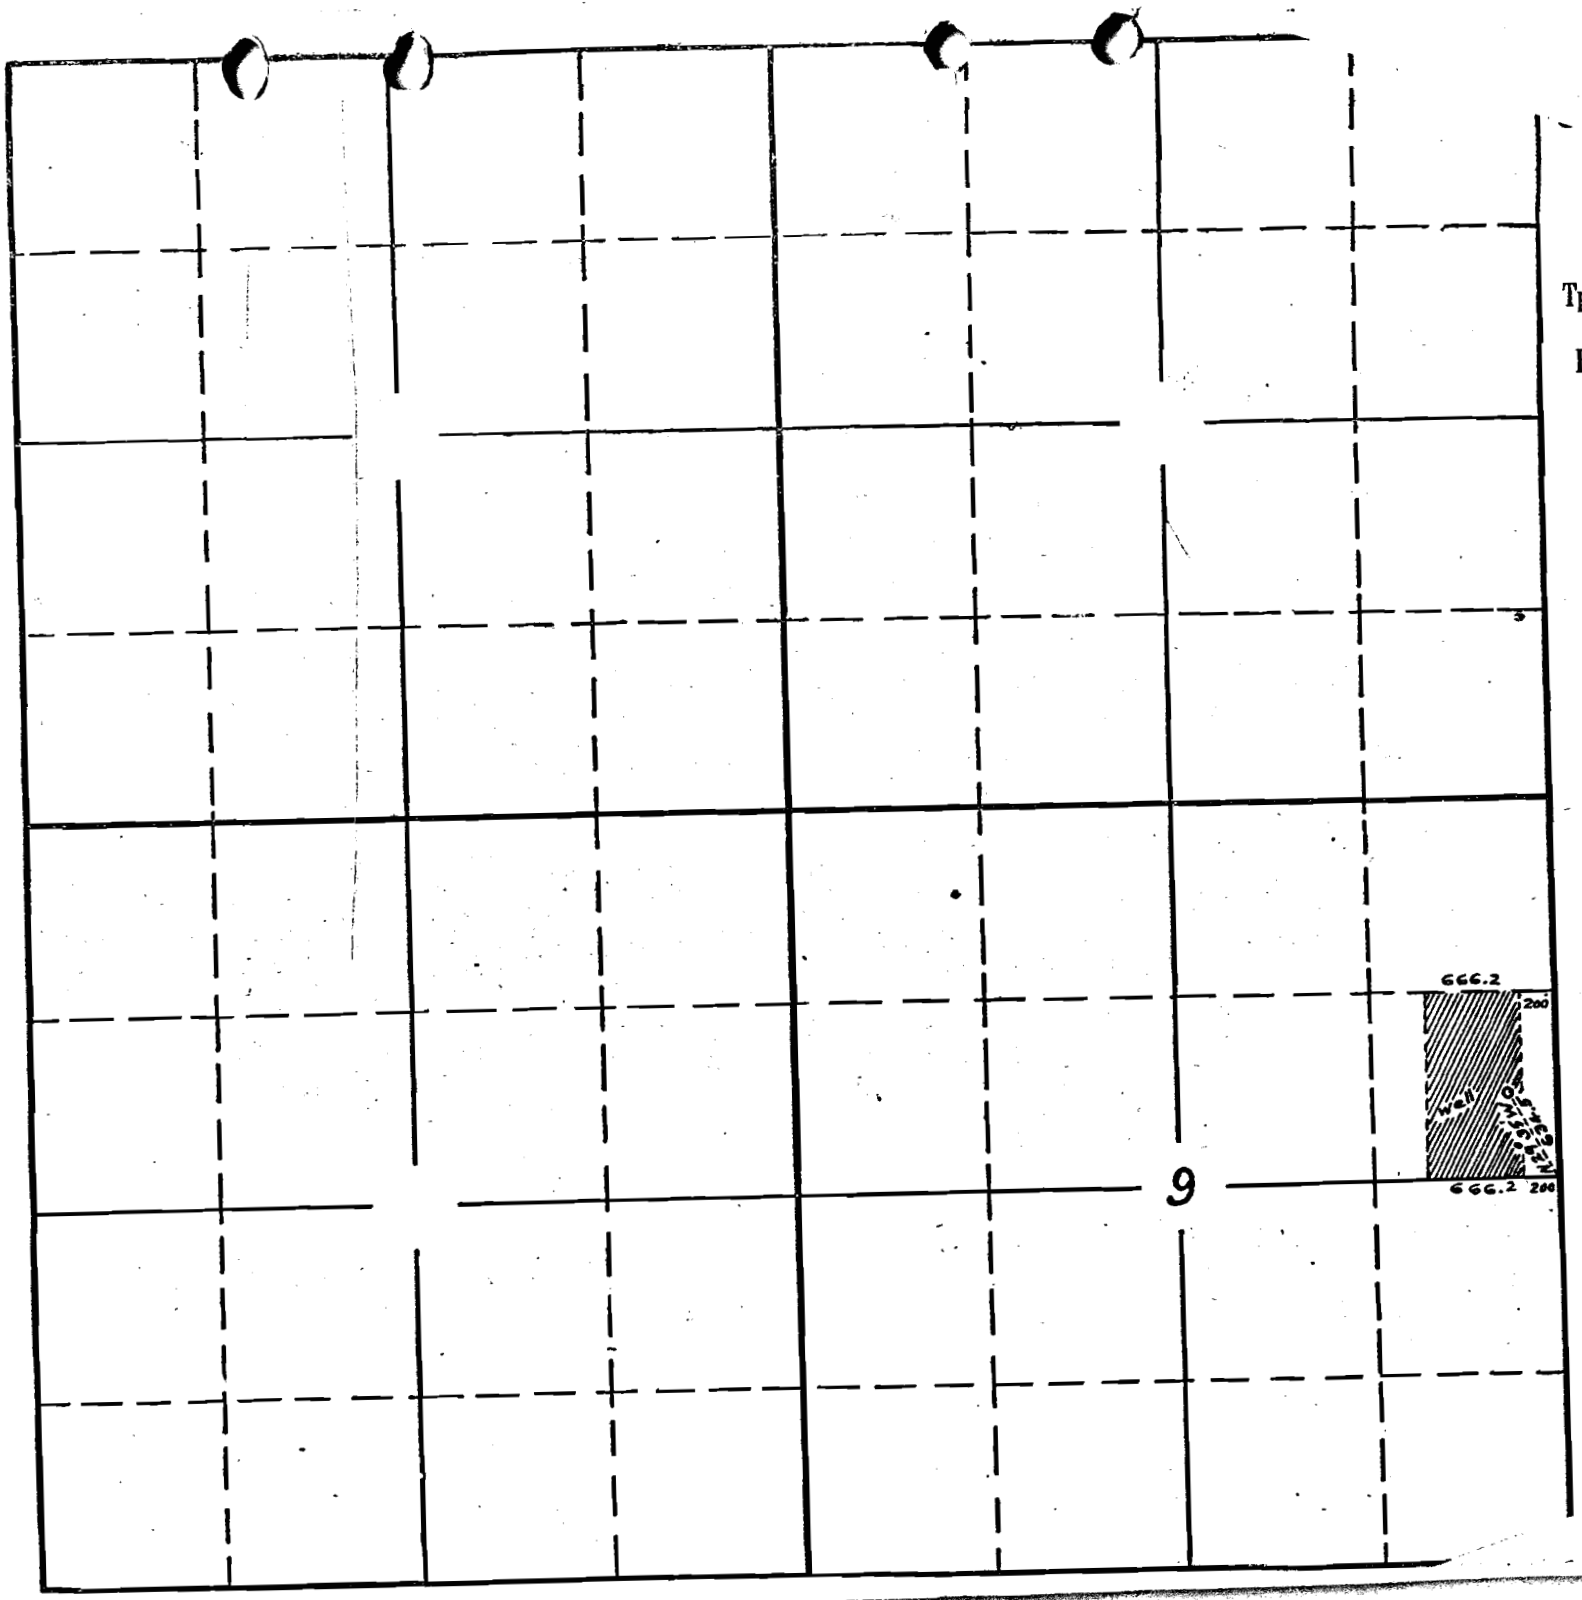

App. No. U-88
Per. No. U-83

U-83
1408