


TOWNSHIP 23 S., RANGE 30 E.

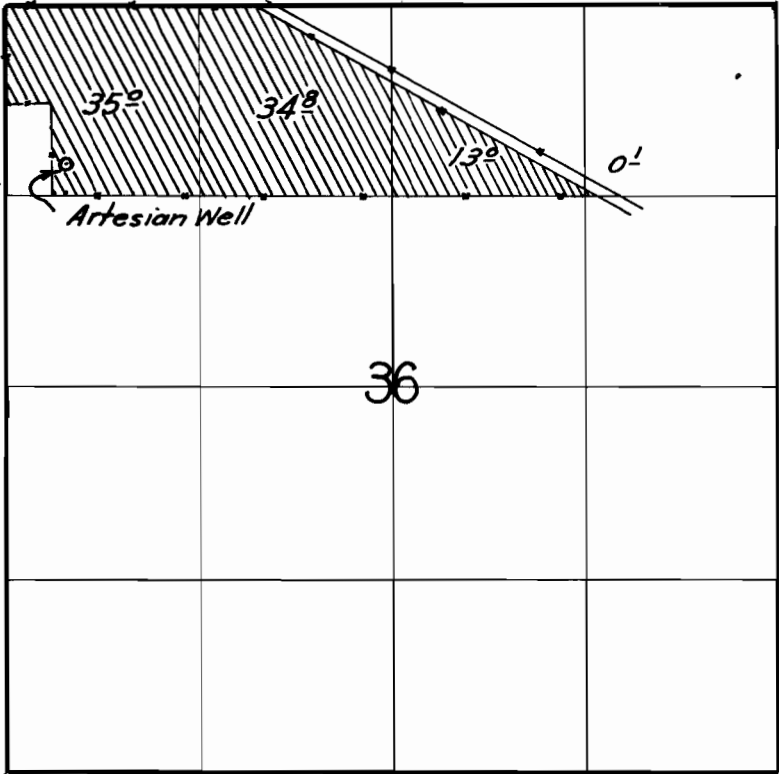

**FINAL PROOF SURVEY**

UNDER

Application No. U-132 Permit No. U-124

IN NAME OF

David G. Cawfield

Surveyed July 24, 1941, by Charles Sumner