


4-134

TOWNSHIP 7N, RANGE 31E W. M.

North

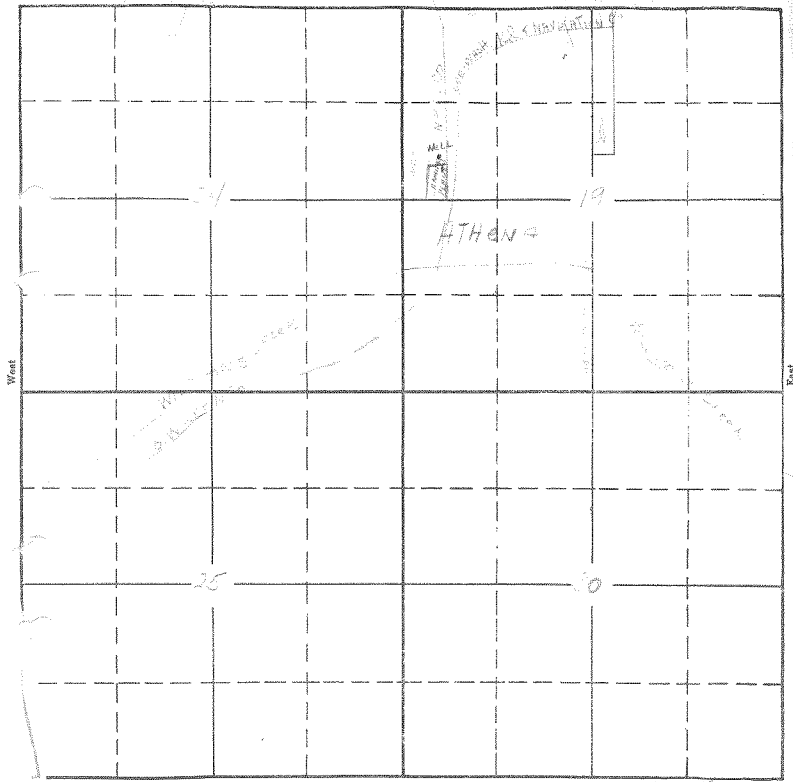

South

APPLICATION No. 4-141  
PERMIT No. 4-134