U-136
C-14090

ATHENA

TWP 4 N RGE 35 E.
Scale 1 Inch = 400 Feet
Sep. 25-1941

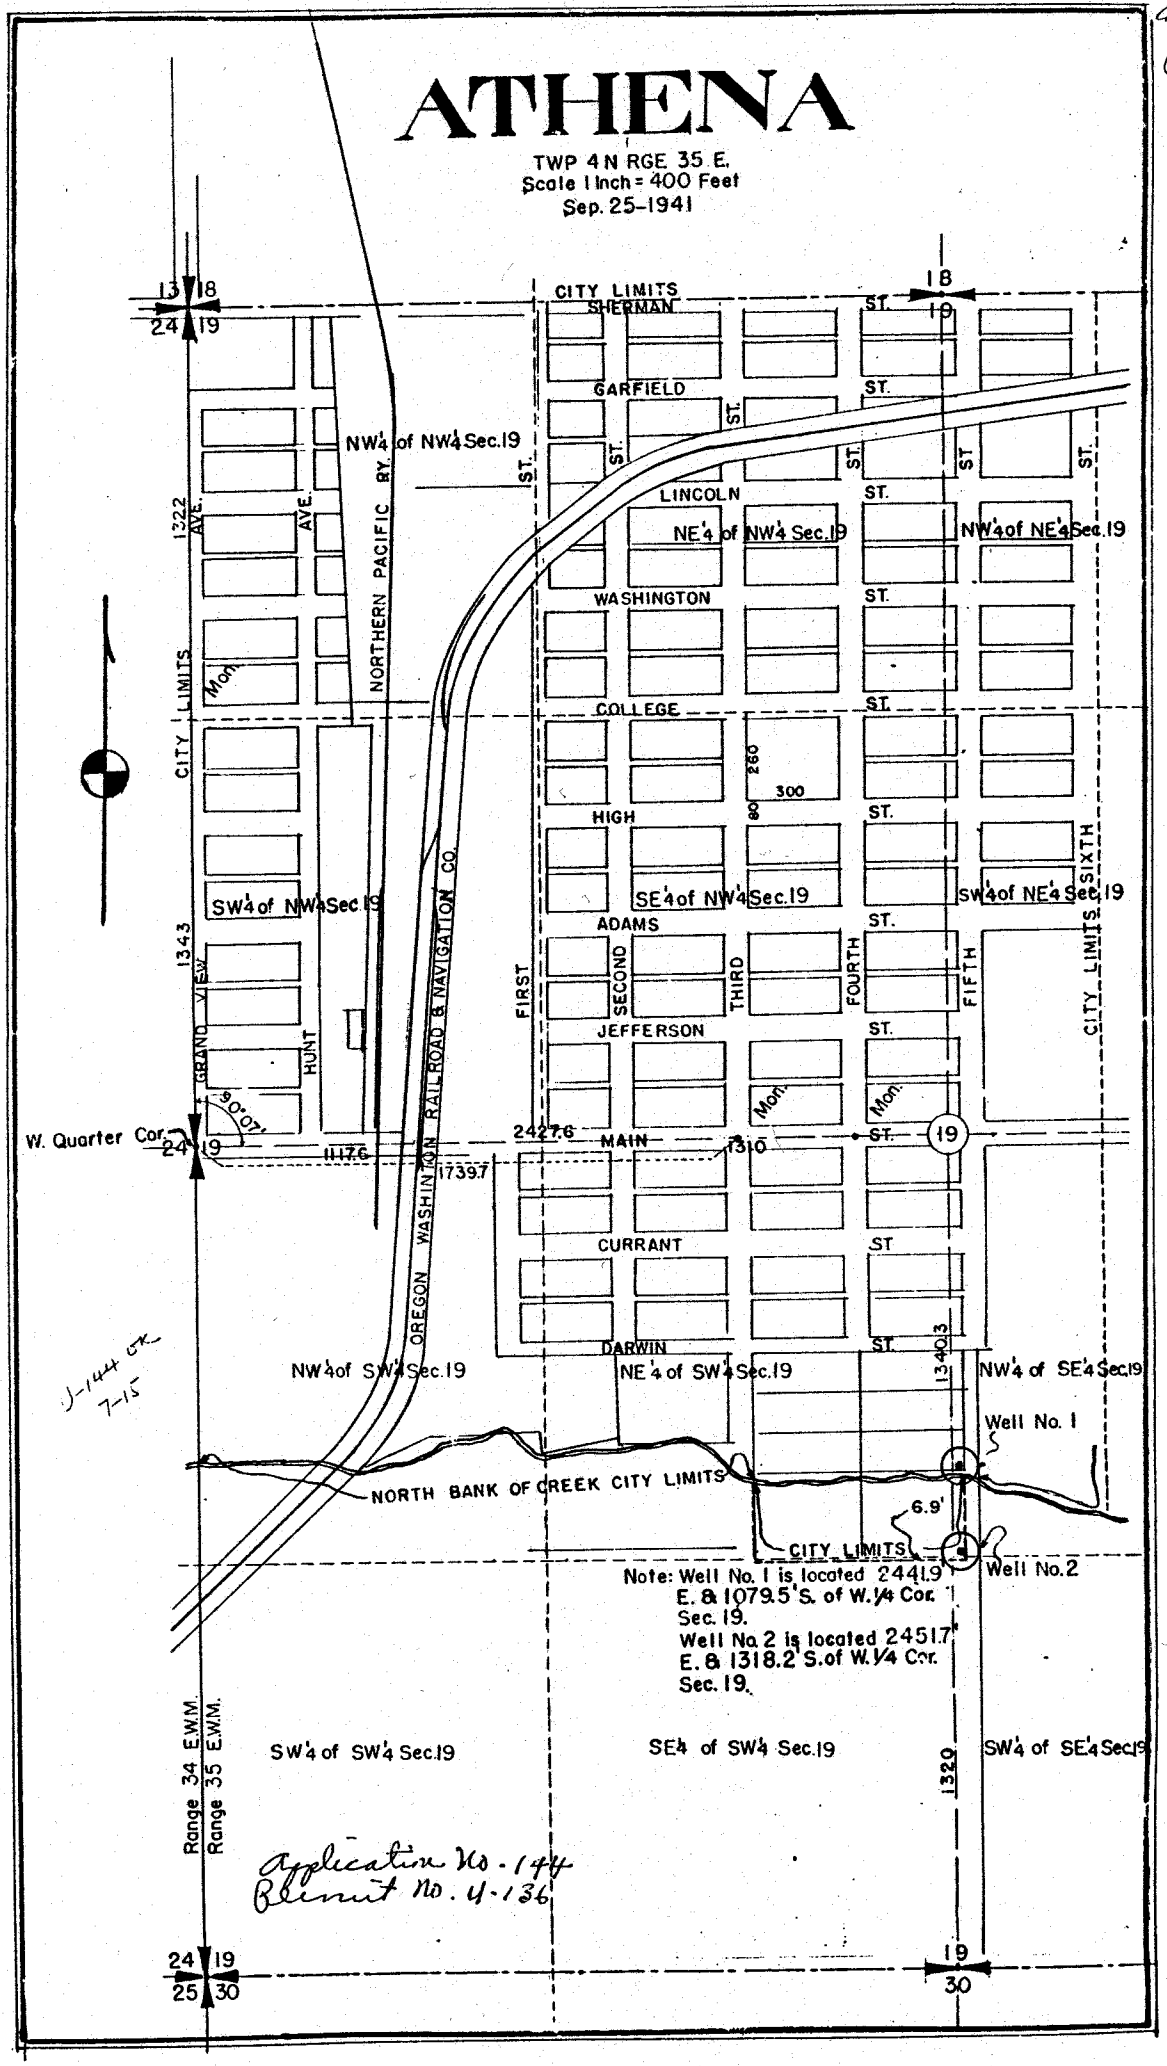

J-144 Ctx. 7-15

Application No. 144
Permit No. 4-136

U-136