


TOWNSHIP 4 N., RANGE 10 W. WM.

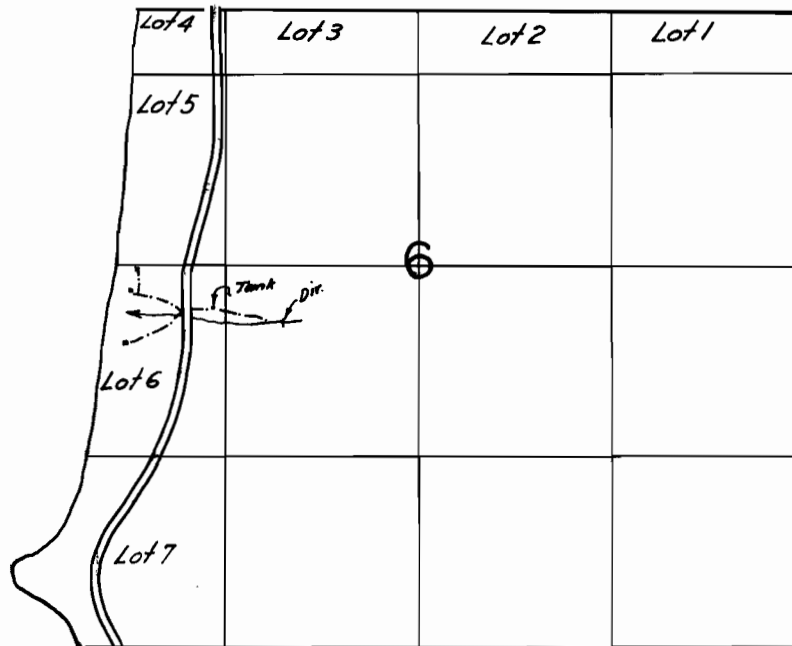

FINAL PROOF SURVEY
UNDER

Application No. 11576 Permit No. 8012

IN NAME OF

Maude P. Wright

Surveyed Aug. 11, 1941, by E. L. Cummings