


14094

App 1238⁰5-8
Permit ~~R64~~ - 8862

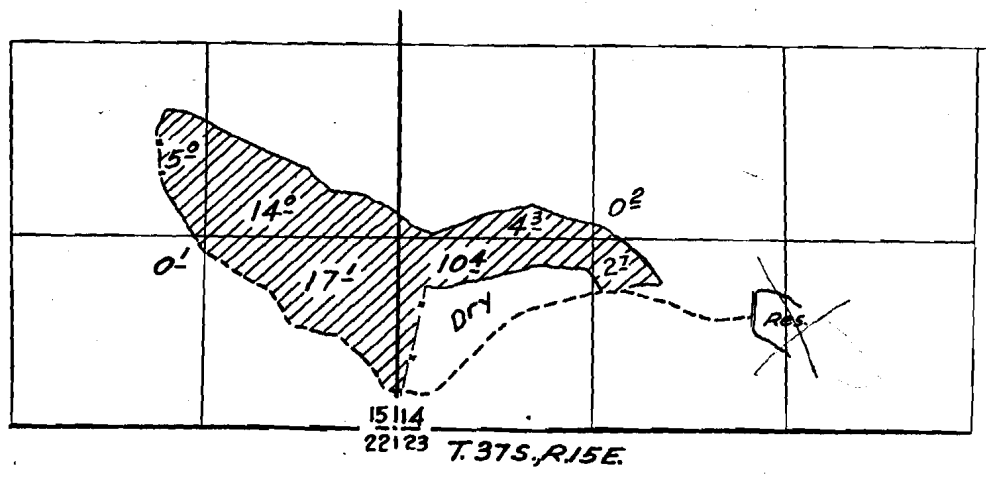

C.S.F. Spreque Misc