


TOWNSHIP 3 S., RANGE 1 E.

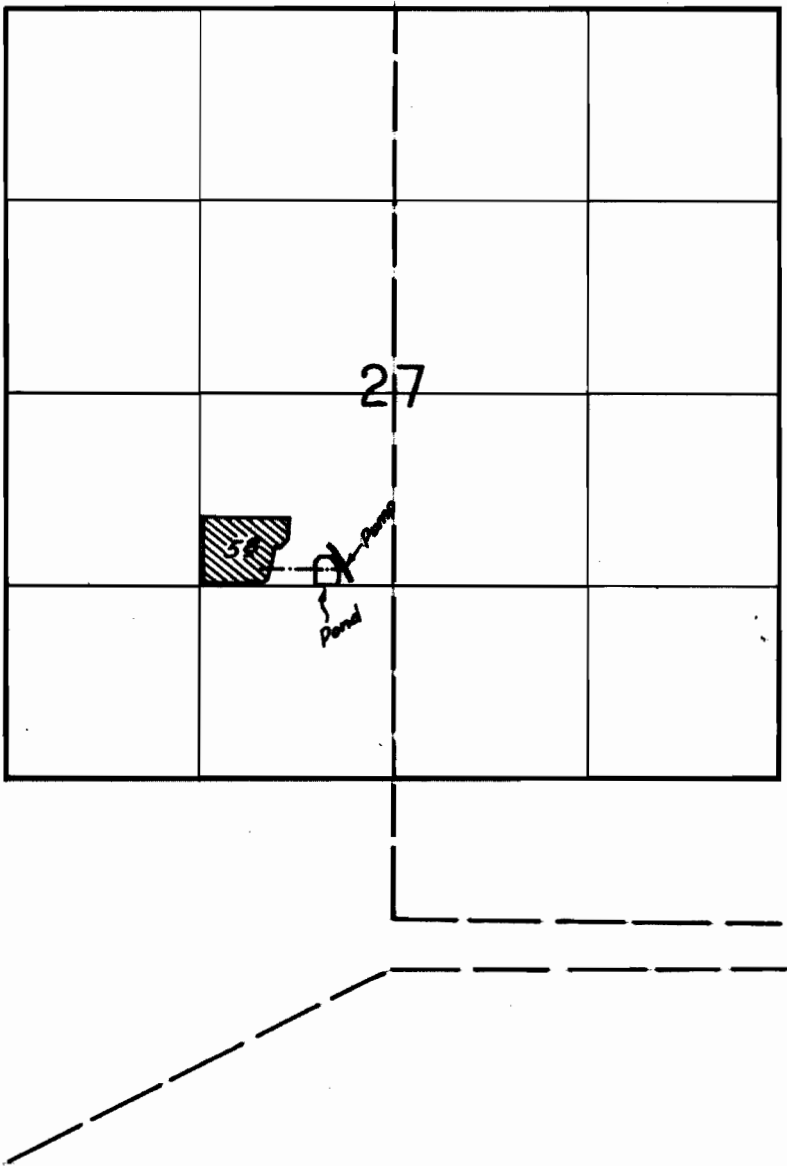

FINAL PROOF SURVEY
UNDER

Application No. 14098 Permit No. 10159

IN NAME OF

Lee L. Hershberger

Surveyed May 27 1941, by Charles Cummings