


TOWNSHIP 12 S., RANGE 6 W

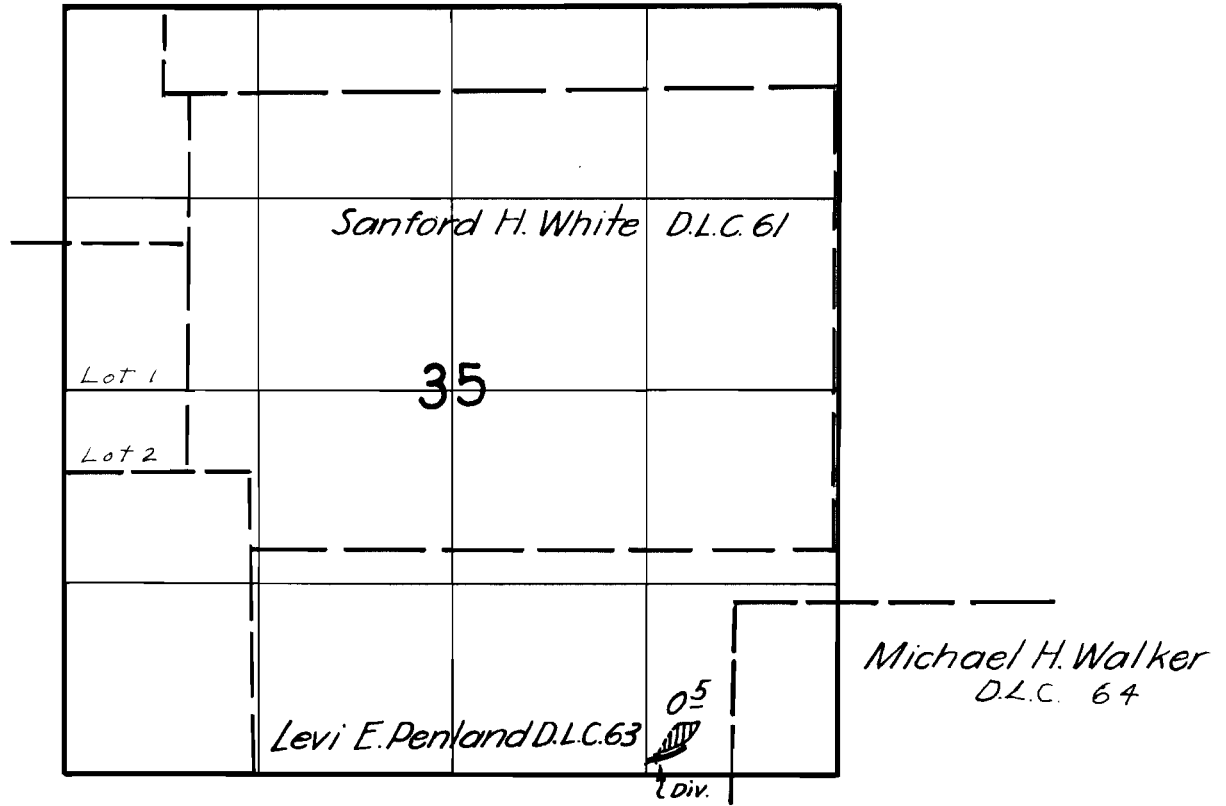

FINAL PROOF SURVEY

UNDER

Application No. 15430 Permit No. 11345

IN NAME OF

Otto H.L. Peterson

Surveyed May 31, 1941, by [Signature]