


TOWNSHIP 14 S., RANGE 12 W.

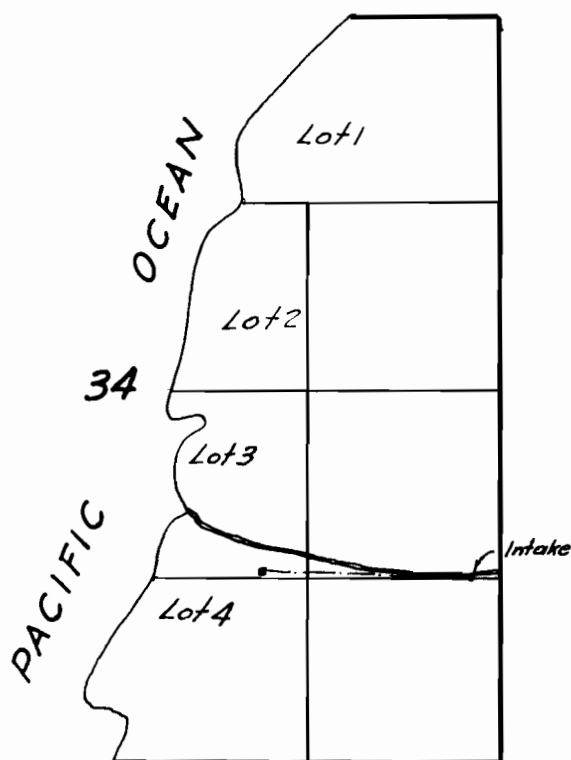

FINAL PROOF SURVEY
UNDER

Application No. 15465 Permit No. 11358

IN NAME OF

A. R. Carpenter

Surveyed Aug. 6, 1941, by B. H. Cunningham