


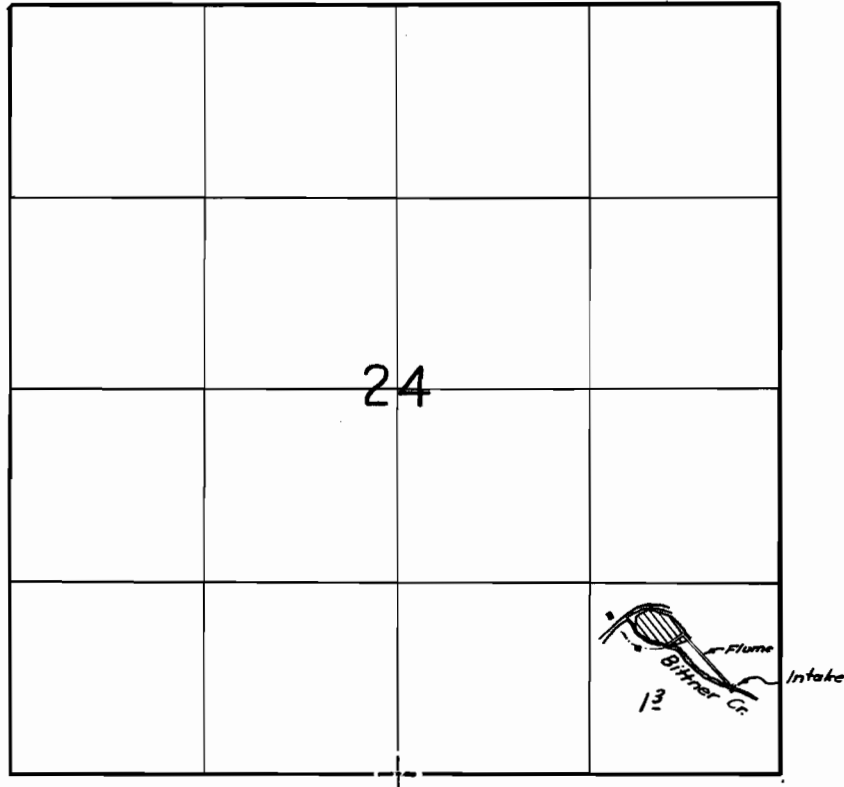

FINAL PROOF SURVEY
UNDER

Application No. 15540 Permit No. 11420

IN NAME OF

Kenneth V. & Bradley J. Woodard

Surveyed May 22, 1941, by Whinnings