



T. 13 S., R. 30 E.

Per 11569
14110

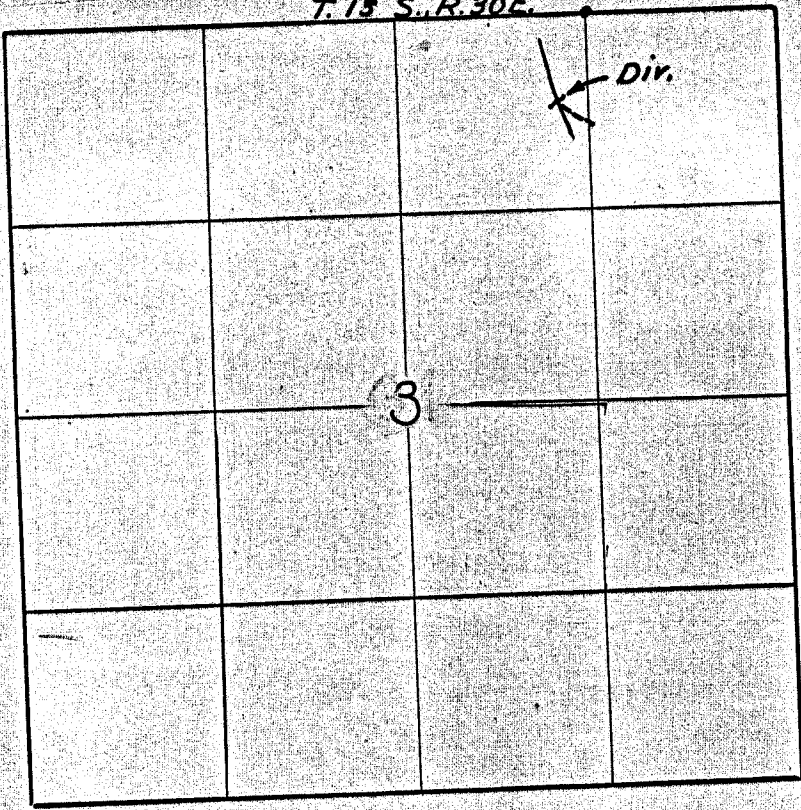

T. 13 S., R. 30 E.

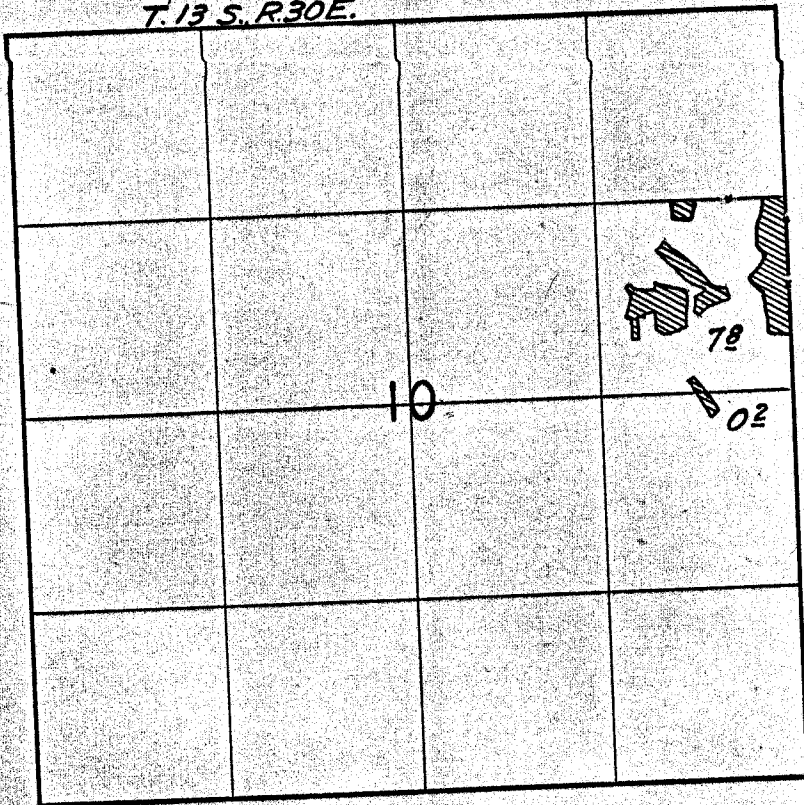

FINAL PROOF SURVEY
UNDER

Application No. 15708 Permit No. 11569

IN NAME OF

R. Lee Thiessen

Surveyed July 12, 1941, by Chas. Lanning