


TOWNSHIP 9 S., RANGE 1 W.

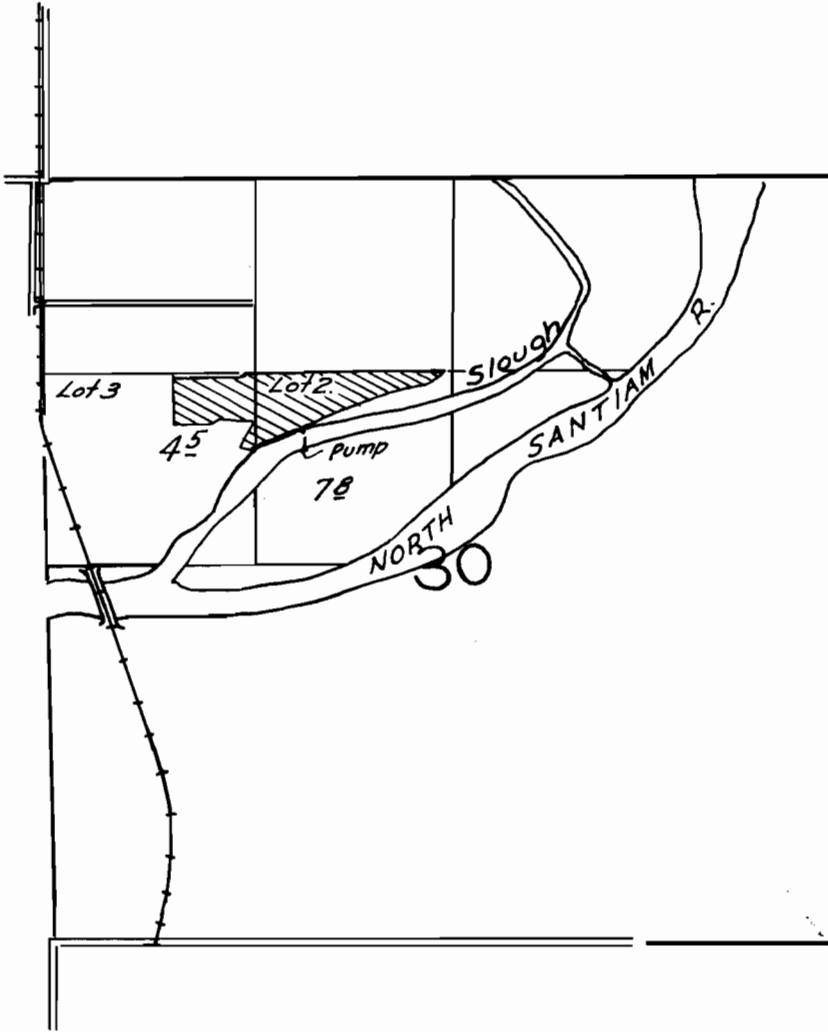

FINAL PROOF SURVEY
UNDER

Application No. 15832 Permit No. 11704

IN NAME OF

M. V. Phillips

Surveyed May 1941, by E. Cummings