

MAP

To accompany the application of Cornelius Lynch.

SECTION 6 TWP 39 S. R 23 E. W. M.

I, R. H. Rogers, of Lakeview, Oregon, do hereby certify that this map was made from notes taken during an actual survey made by me on May 24, 1935, and that it correctly represents the works described in the accompanying application together with the location of streams and other ditches in the immediate vicinity.


R. H. Rogers

REGISTERED PROFESSIONAL ENGINEER.
OREGON NO 789. DEC 31, 1919.

 Irrigated area.

App. No. 15693
Per. No. 11884

13-333
A15693-

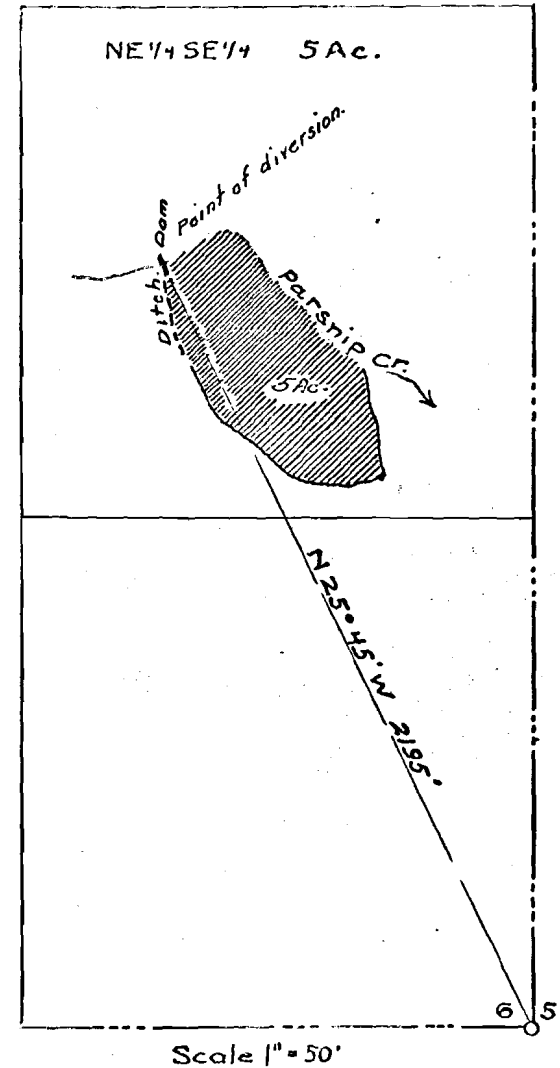

11884
11113

39-23 ✓