

To accompany the application of Cornelius Lynch.

C.M.H.H.


I, R.H. Rogers, of Lakeview, Oregon, do hereby certify that this map was made from notes taken during an actual survey made by me on June 5th and 9th 1935, and that it correctly represents the works described in the accompanying application together with the location of streams and other ditches in the immediate vicinity.

R.H. Rogers

Registered Professional Engineer, Oregon Number 789.

December 31, 1919.

Section 14 T40S-R21E W.M.

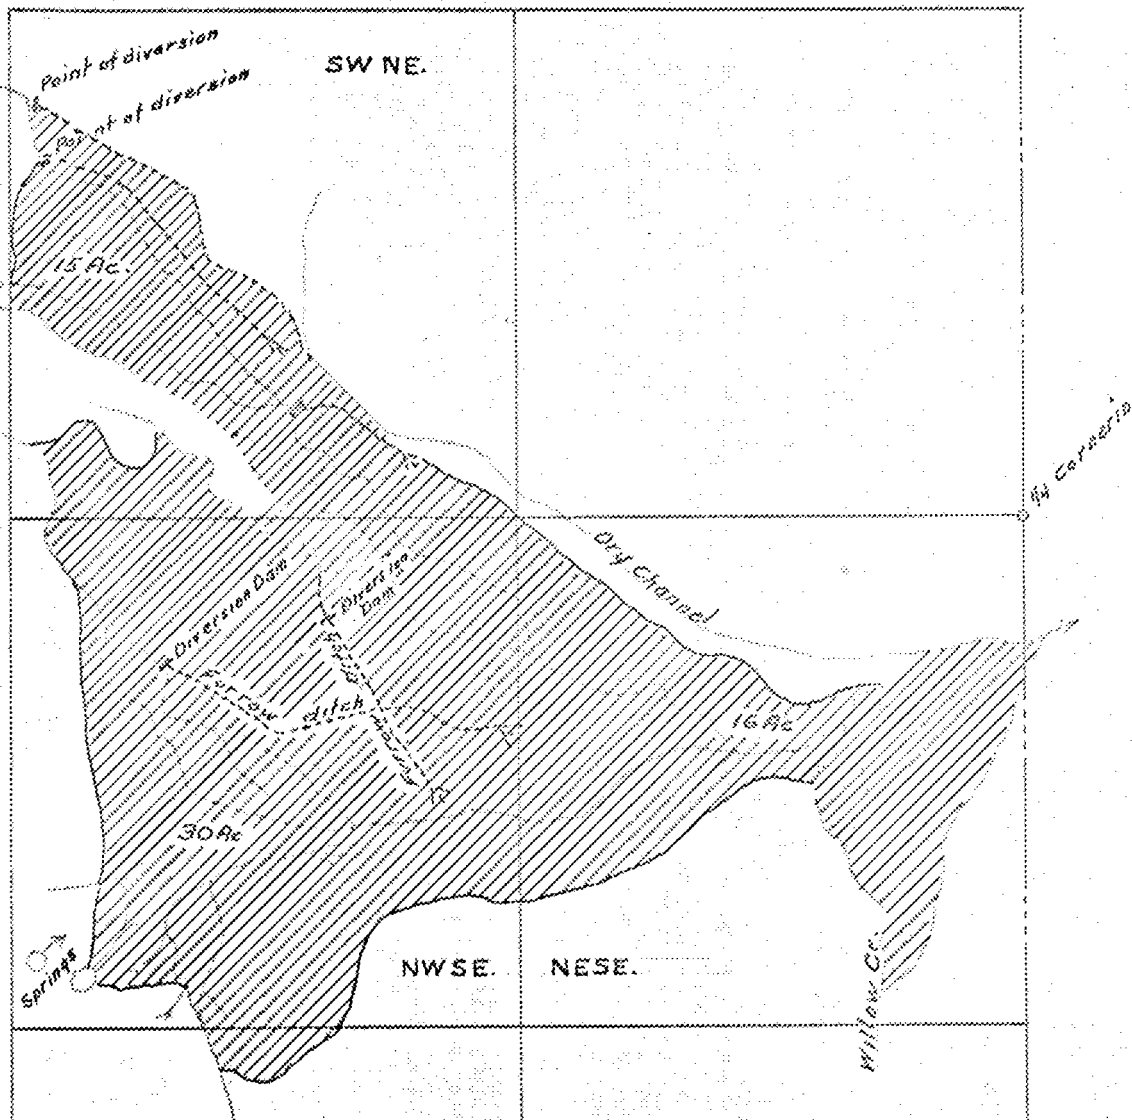

App. No. 15695
Per. No. 11885

40-21 ✓