


TOWNSHIP 4 S. RANGE 2 E.

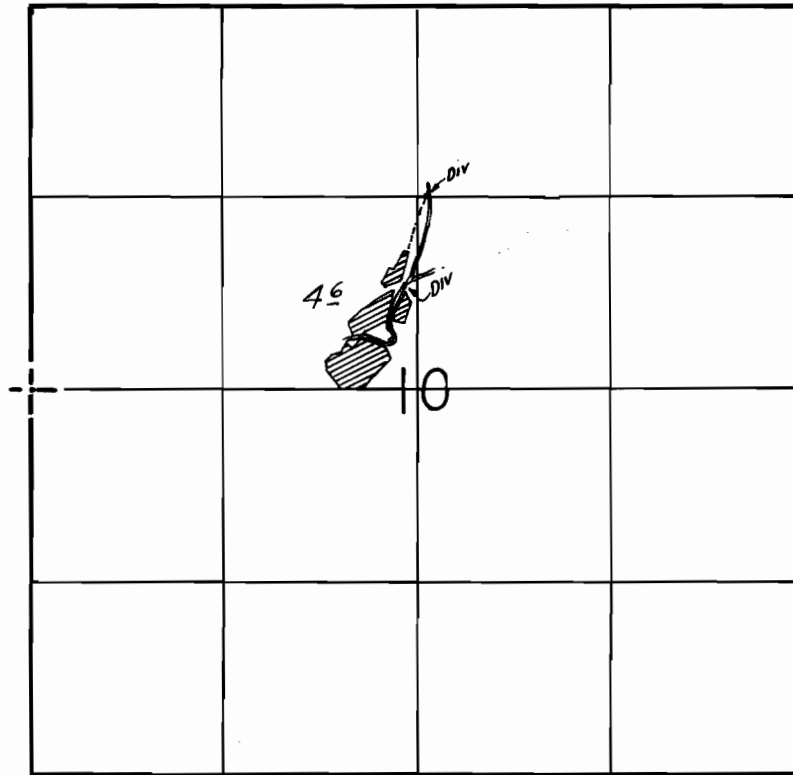

FINAL PROOF SURVEY

UNDER

Application No. 16151 Permit No. 11967

IN NAME OF

V. H. Whitman

Surveyed May 24 1941, by E. L. Cummings