


TOWNSHIP 3 S., RANGE 2 W.

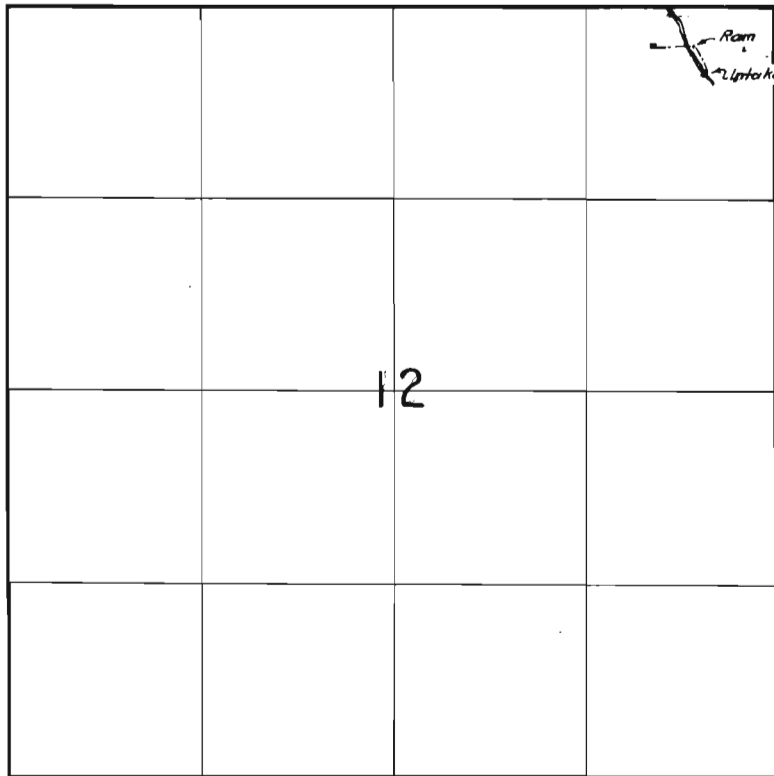

FINAL PROOF SURVEY
UNDER

Application No. 16150 Permit No. 12071

IN NAME OF

Ethel L. Burdick

Surveyed May 28 1941, by Ed Cummings