


TOWNSHIP 6 S., RANGE 3 W.

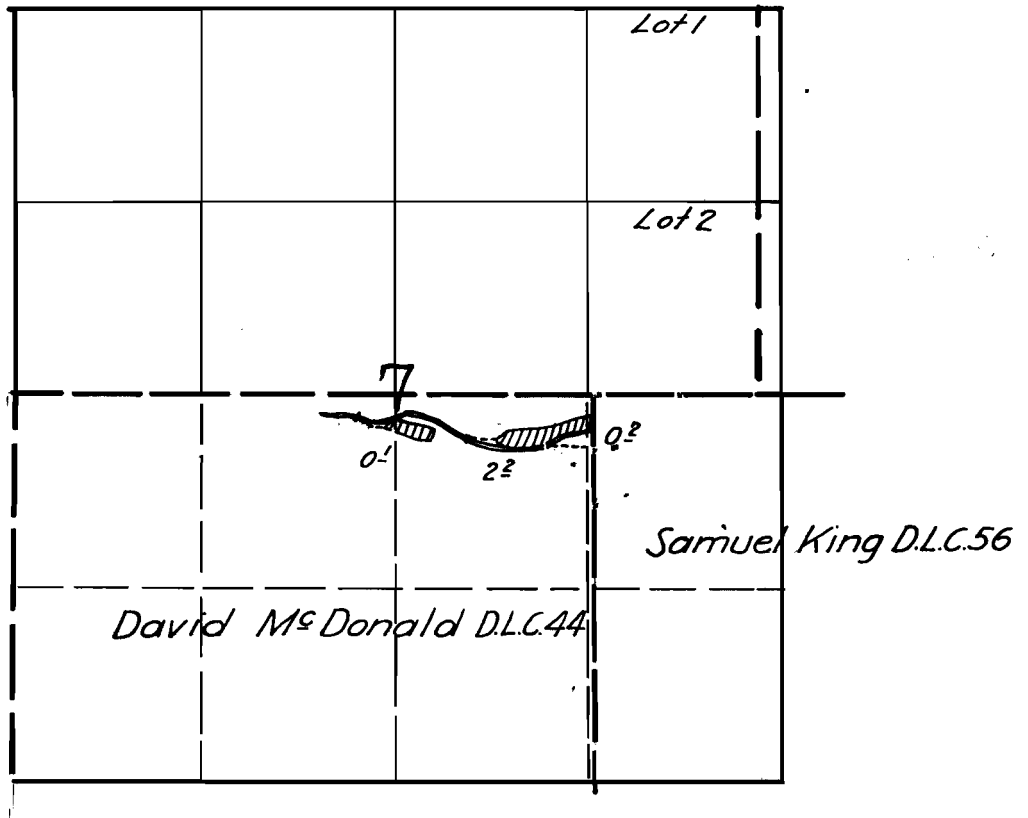

FINAL PROOF SURVEY

UNDER

Application No. 16282 Permit No. 12093

IN NAME OF

L. E. Swanwald

Surveyed May 14 1941, by E. E. Cummings