


Lost to mac.

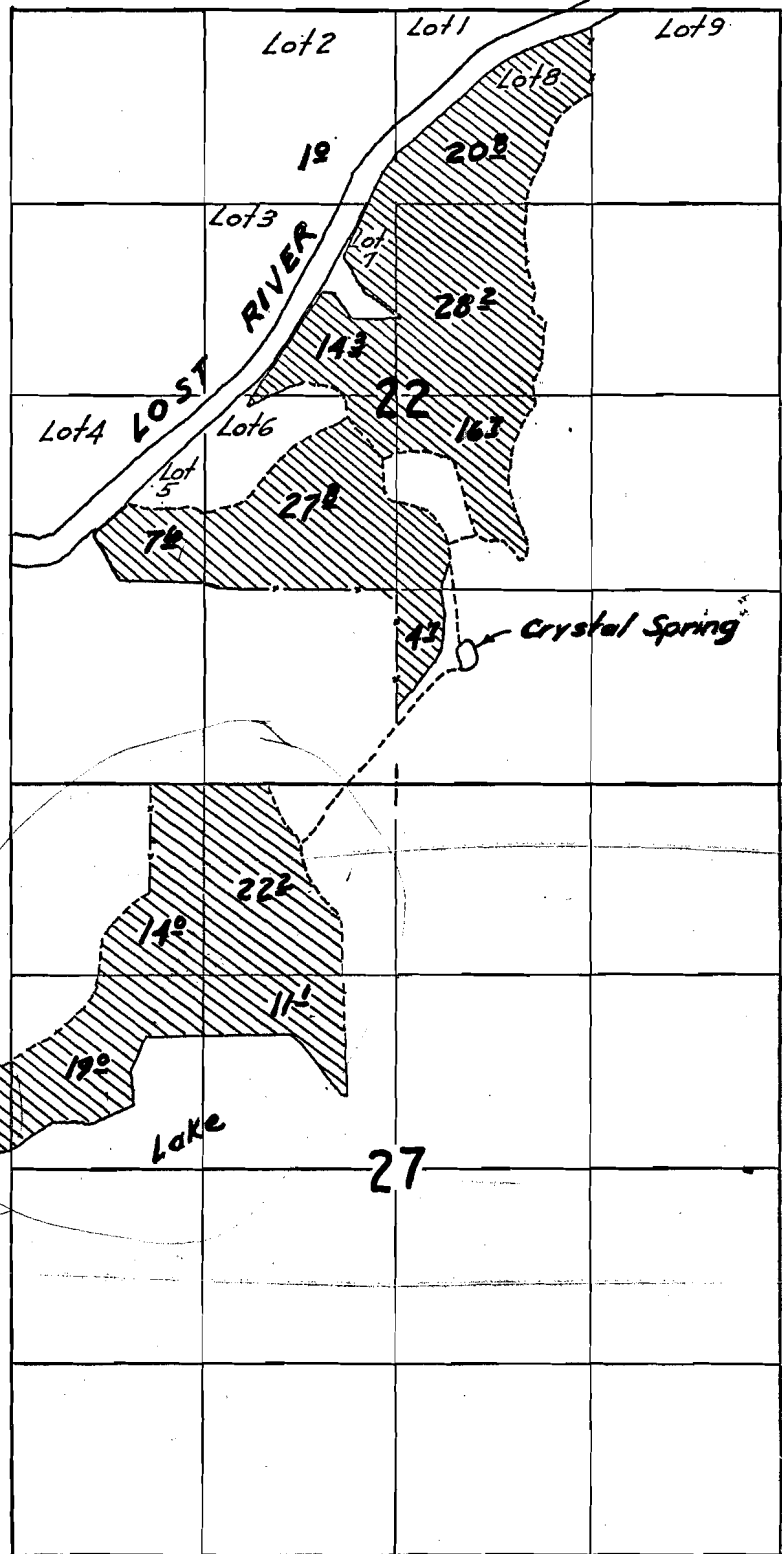

FINAL PROOF SURVEY
UNDER

Application No. 16439 Permit No. 12237

IN NAME OF

L. O. Mills & R. R. Kinsey

Surveyed July 19, 1941, by Charles C. Cummings