


TOWNSHIP 11S., RANGE 5W.

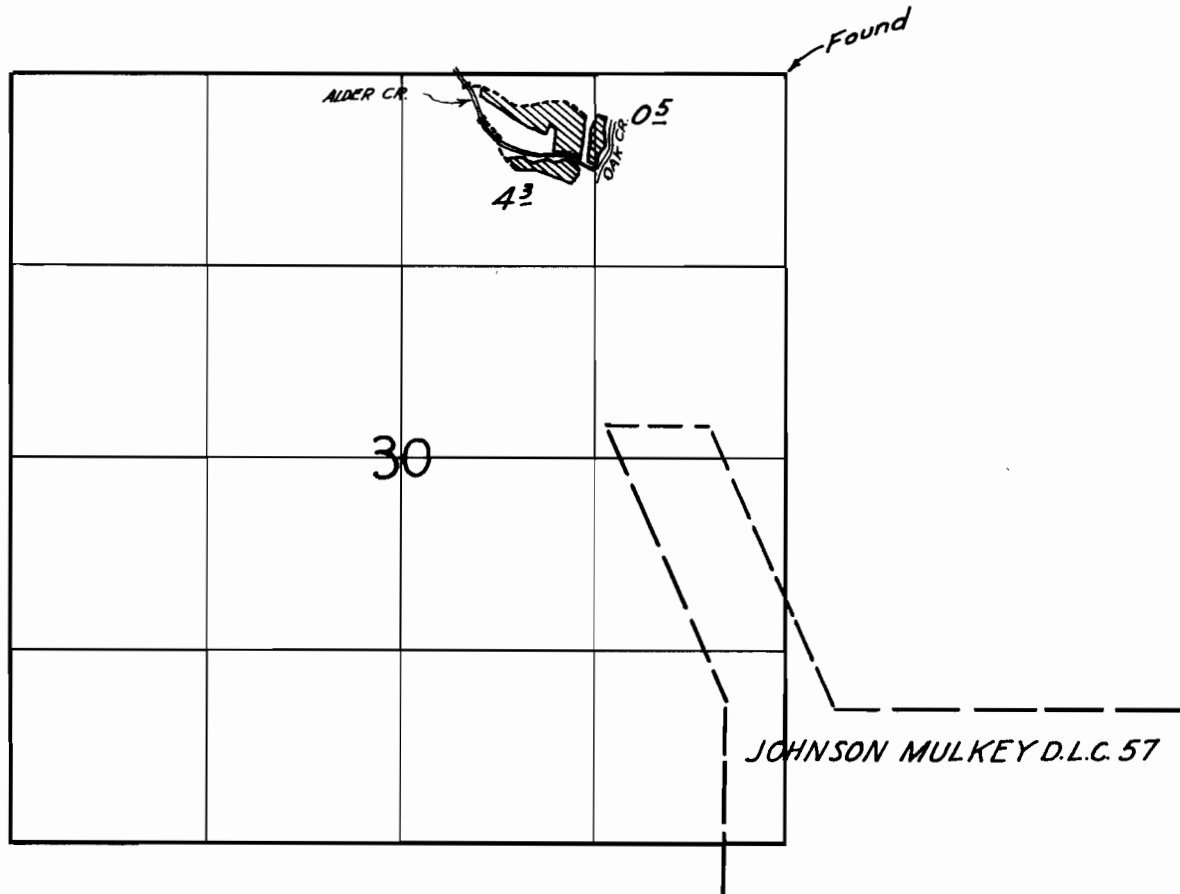

FINAL PROOF SURVEY
UNDER

Application No. 16468 Permit No. 12263

IN NAME OF

E. E. Wilson

Surveyed Aug. 5, 1941, by Chas. C. Cummings