


TOWNSHIP 10S., RANGE 6W

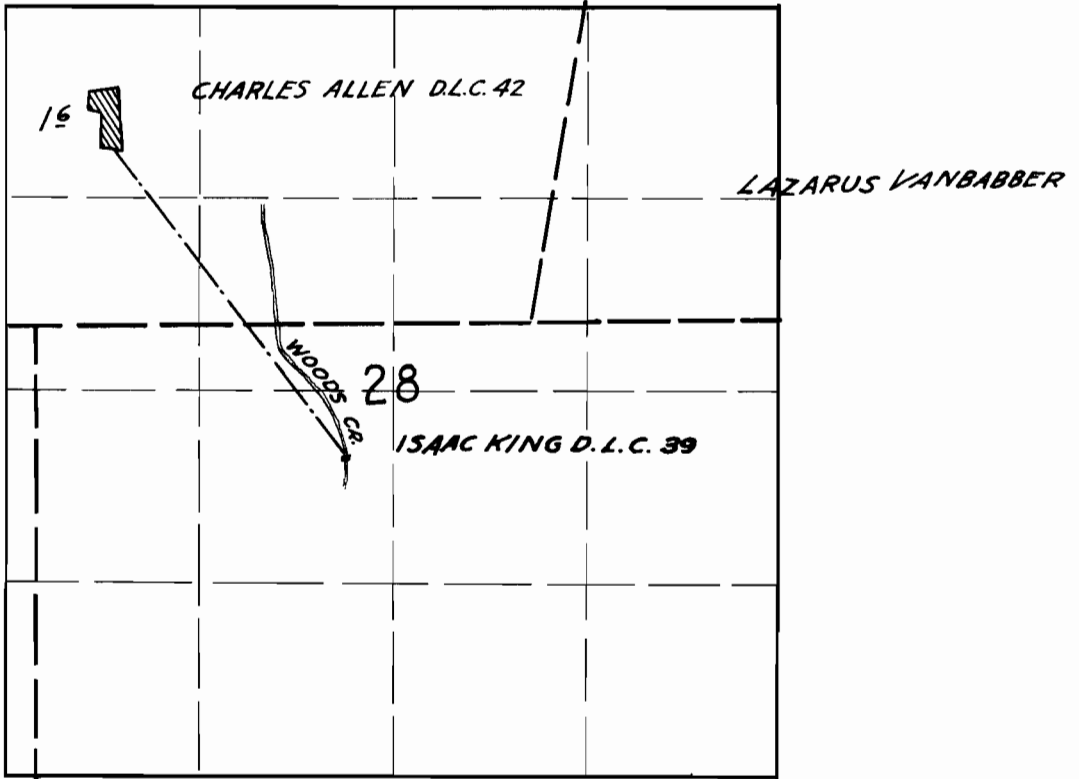

FINAL PROOF SURVEY
UNDER

Application No. 16477 Permit No. 12281

IN NAME OF

C. W. Chambers

Surveyed Aug. 5 1941, by Charles Hemming