


TOWNSHIP 14S., RANGE 1W.

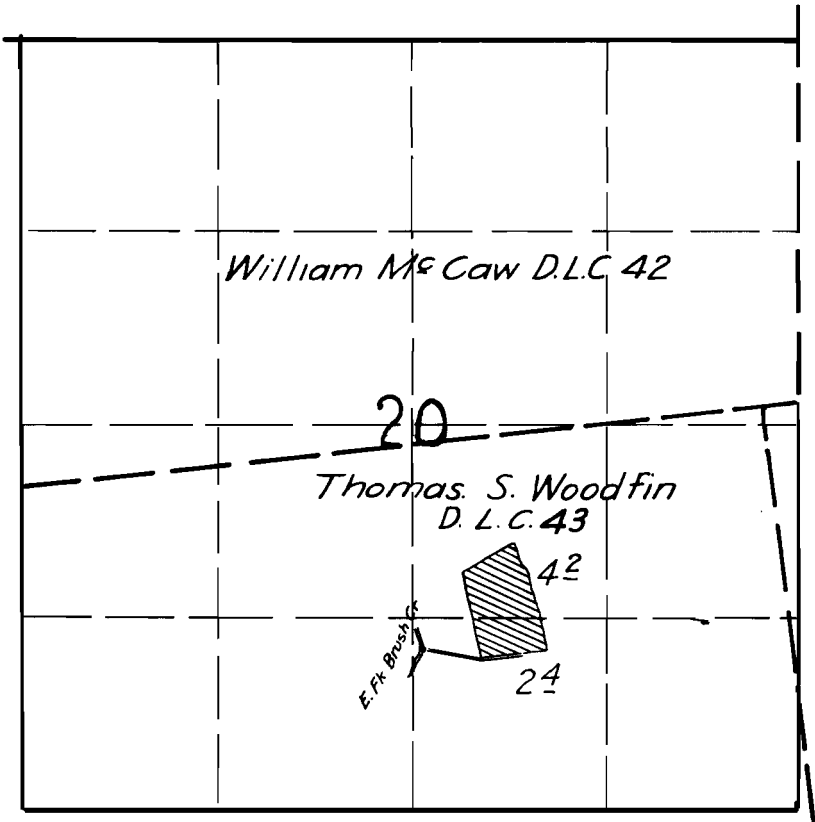

FINAL PROOF SURVEY
UNDER

Application No. 16540 Permit No. 12333

IN NAME OF

Frederick W. Bullack

Surveyed June 2, 1941, by C. Hummery