


TOWNSHIP 4 S., RANGE 1 E.

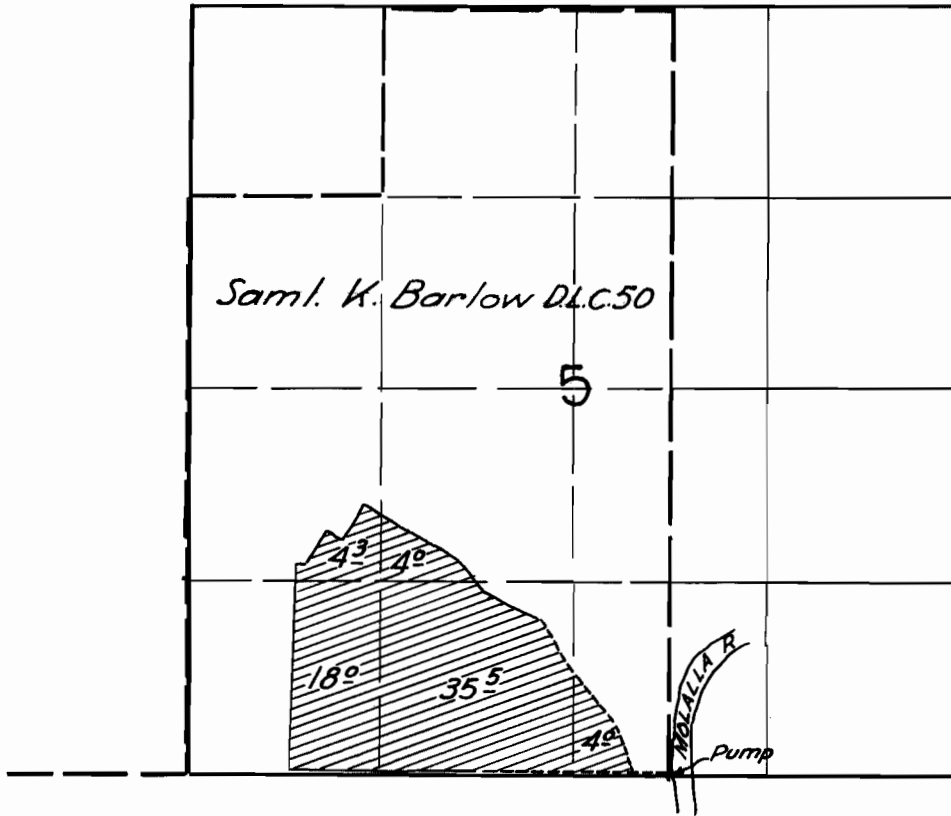

FINAL PROOF SURVEY
UNDER

Application No. 16237 Permit No. 12460

IN NAME OF

Berg Brothers

Surveyed May 27 1941, by Blumming