


T. 4 S., R. 4 W. W.M.

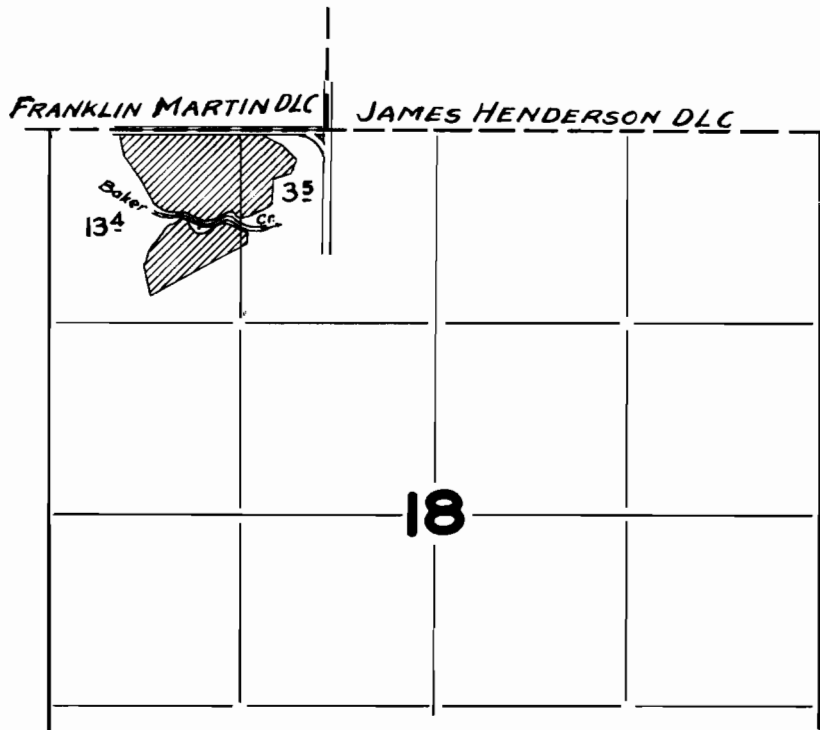

FINAL PROOF SURVEY

UNDER

Application No. ¹⁶⁶⁶⁴ ~~17572~~ Permit No. ¹²⁴³⁵ ~~13272~~

IN FAVOR OF

Will M. Coleman

Surveyed Apr. 28, 1941, by C. A. Cummings

Reinspected Aug. 13, 1942, by Geo. W. Naderman