


SECTION

TOWNSHIP _____, RANGE _____, W. M.

North

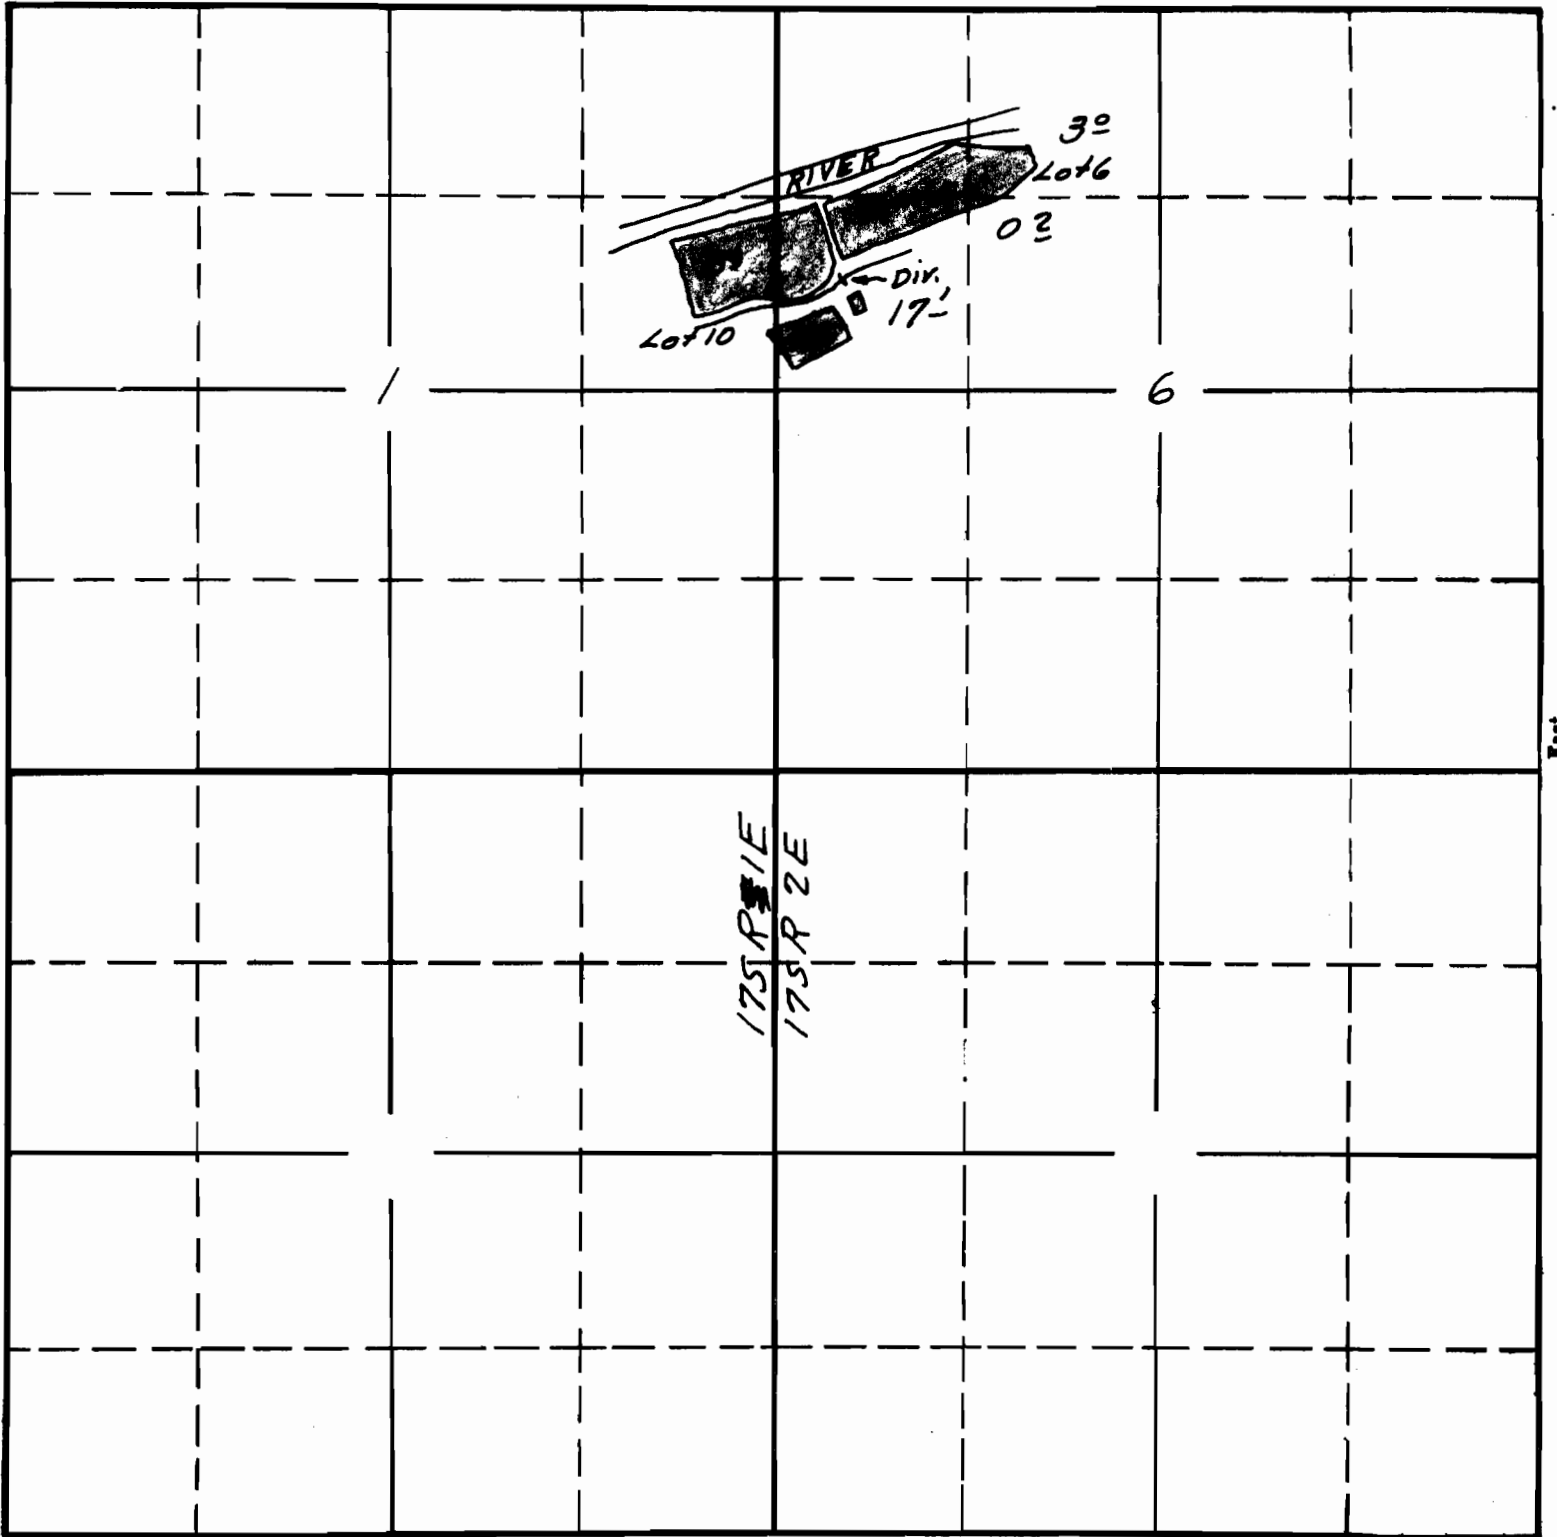

Surveyed June 4 1941
C.A.G.

South

APPLICATION No. 16759
PERMIT No. 12536