


TOWNSHIP 6 S., RANGE 2 W.

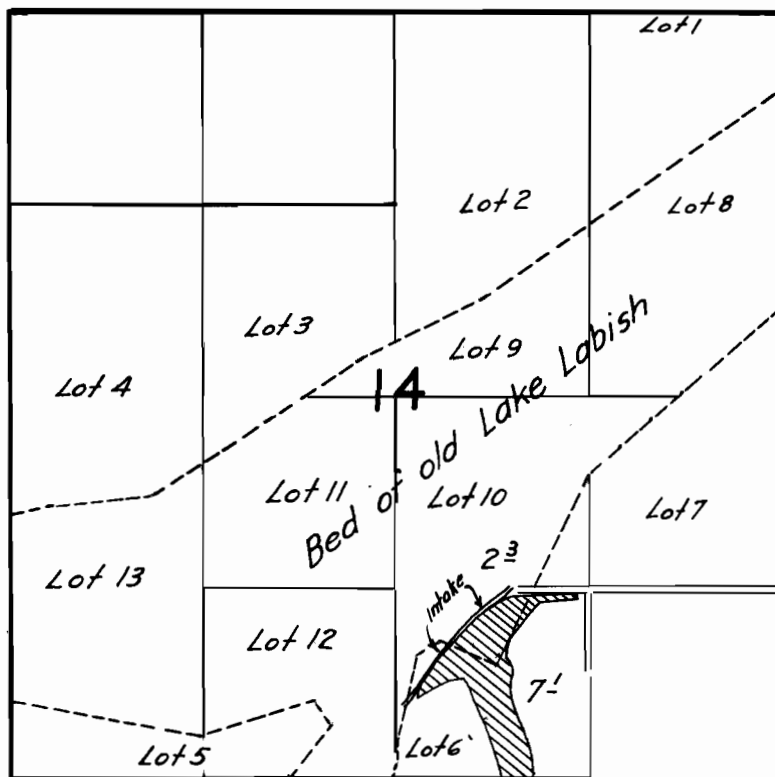

FINAL PROOF SURVEY
UNDER

Application No. 16833 Permit No. 12591

IN NAME OF

C. E. McIlwain

Surveyed May 8, 1941, by [Signature]