


Per 12603
14142

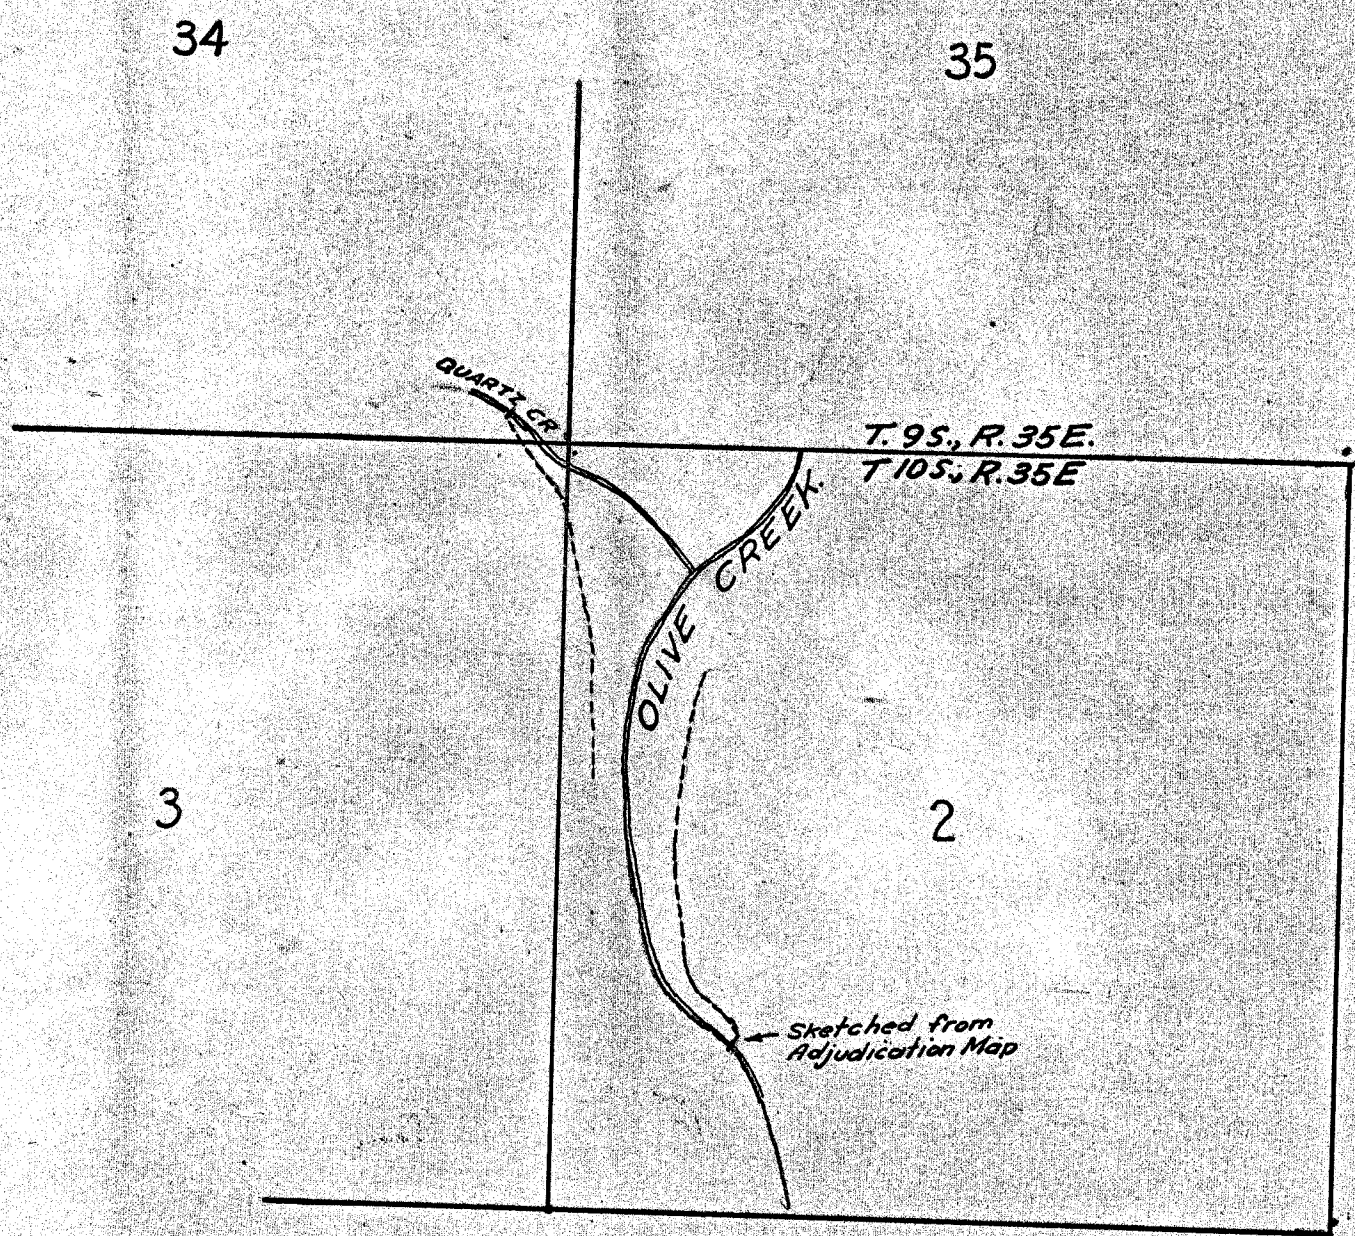

FINAL PROOF SURVEY
UNDER

Application No. 16837 Permit No. 12603

IN NAME OF

Harry J. Yount

Surveyed Aug 1 1941, by Charles C. Cummings