


P. 12606  
14144

TOWNSHIP 13 S., RANGE 26 E.

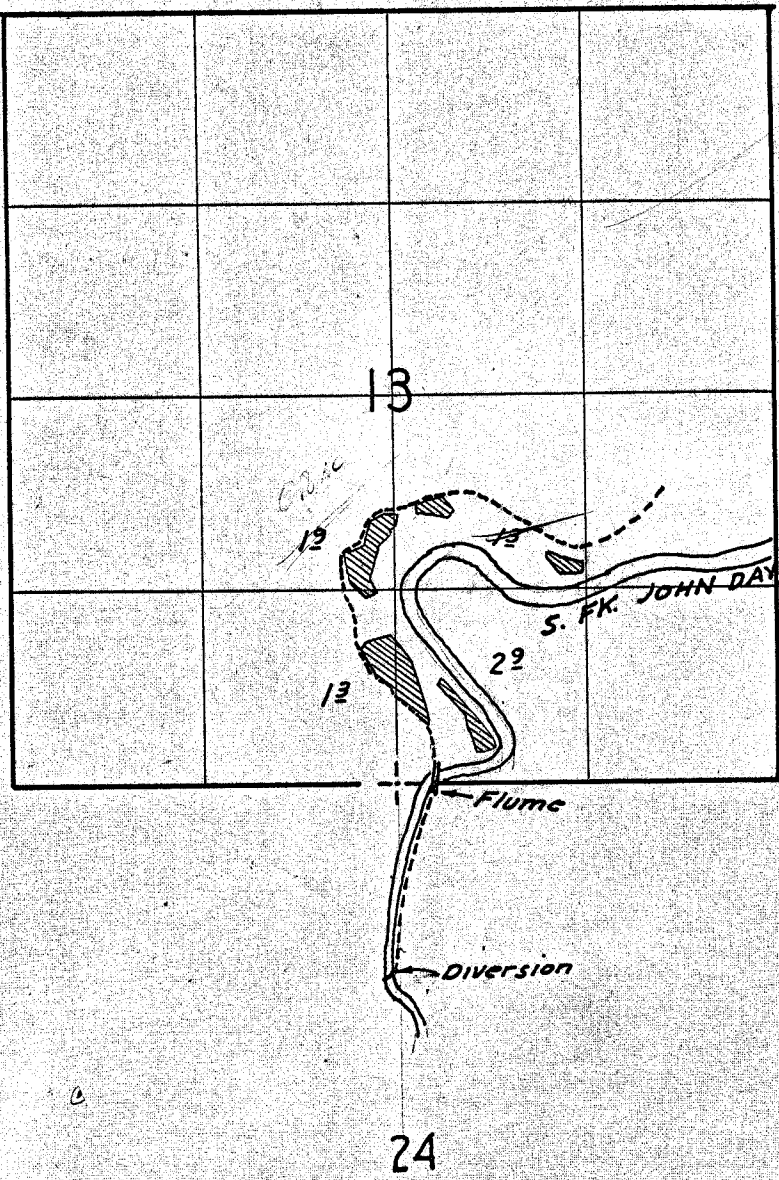

**FINAL PROOF SURVEY**  
UNDER

Application No. 16841 Permit No. 12606

IN NAME OF

Gladys Munjar

Surveyed July 13, 1941, by Charles Cummings