


TOWNSHIP 3 S., RANGE 3 W

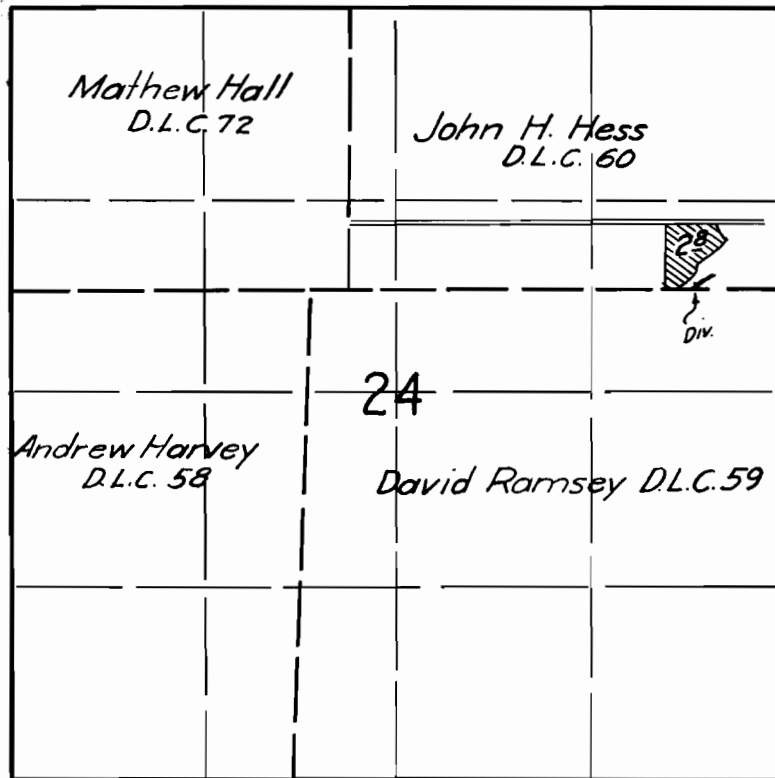

FINAL PROOF SURVEY
UNDER

Application No. 16855 Permit No. 12615

IN NAME OF

Robert Thiel

Surveyed May 1, 1941, by Ed Cummins