


TOWNSHIP 2 N., RANGE 1 W.

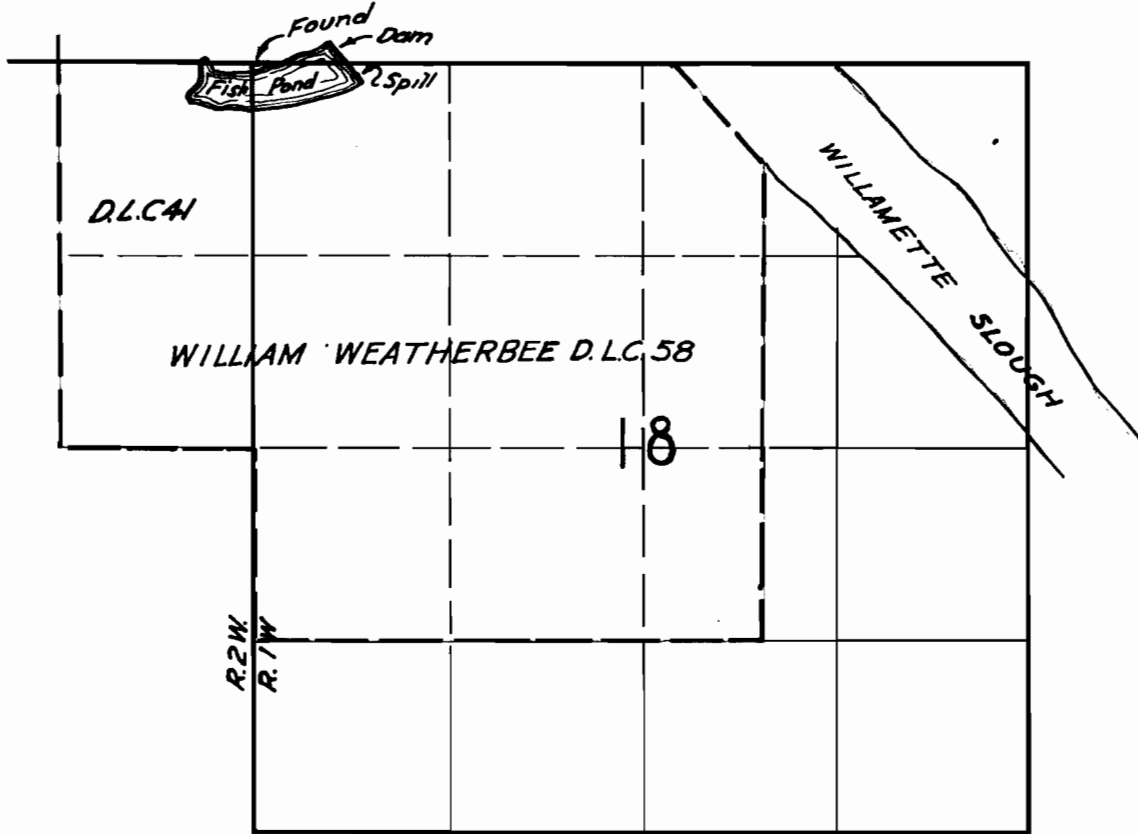

FINAL PROOF SURVEY

UNDER

Application No. 17000 Permit No. 12744

IN NAME OF

William Honeyman

Surveyed Aug 13, 1941, by *Chester Cummings*