


T. 12 S., R. 6 W.

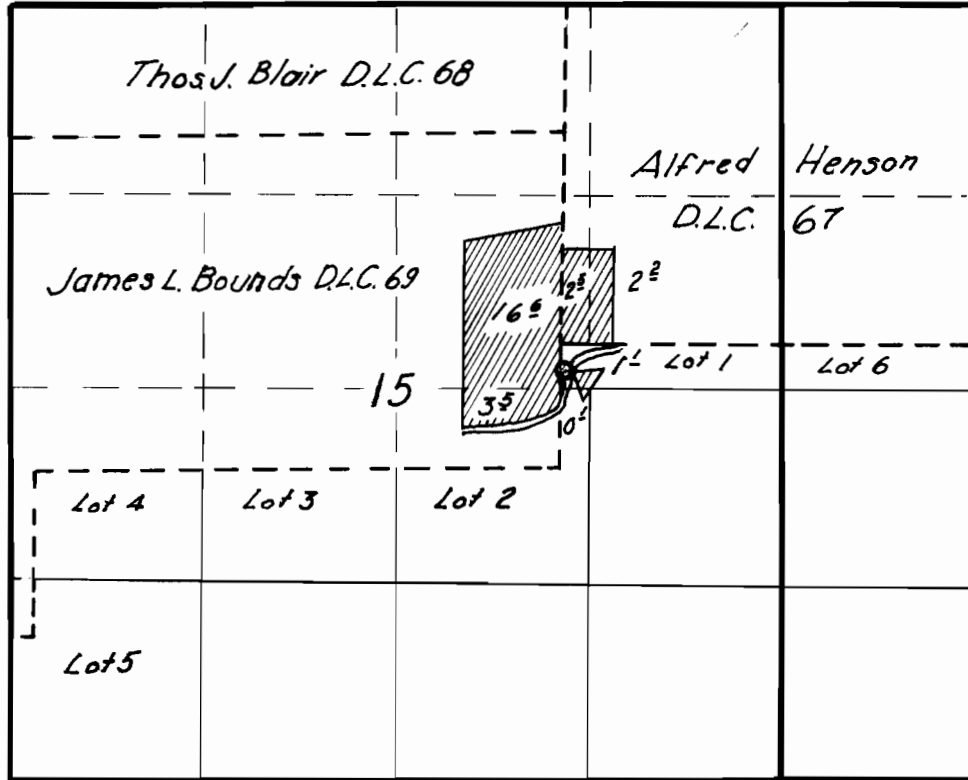

FINAL PROOF SURVEY

UNDER

Application No. 17004 Permit No. 12748

IN NAME OF

C. A. Shafer

Surveyed May 31, 1941, by Chester A. Cummings