


TOWNSHIP 15 S., RANGE 4 W.

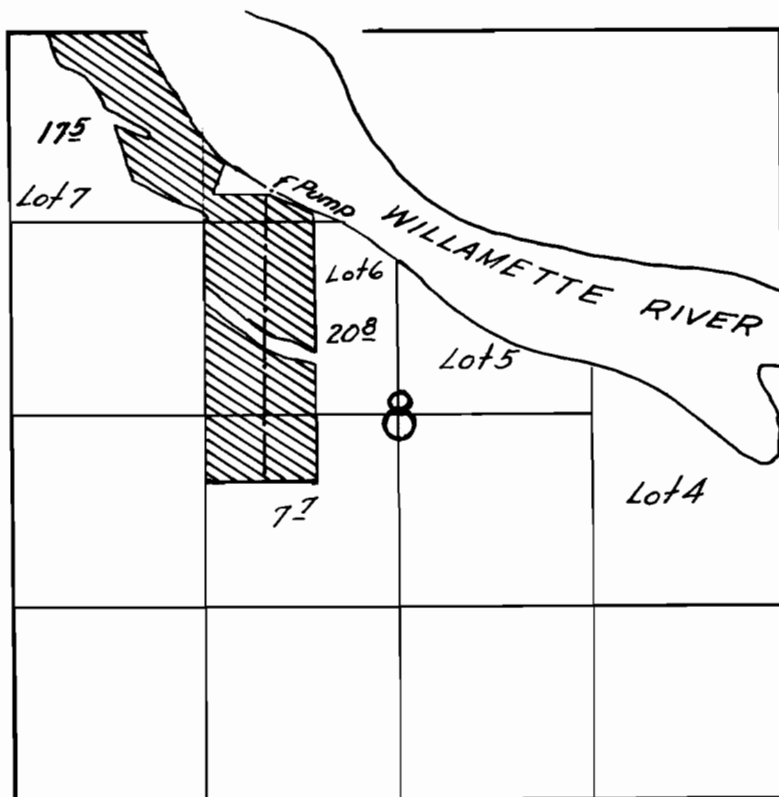

**FINAL PROOF SURVEY**  
UNDER

Application No. 17007 Permit No. 12753

IN NAME OF

Richard C. Kuehner

Surveyed May 29 1941 by Blumming