


TOWNSHIP 4 S. RANGE 9 W. W. M.

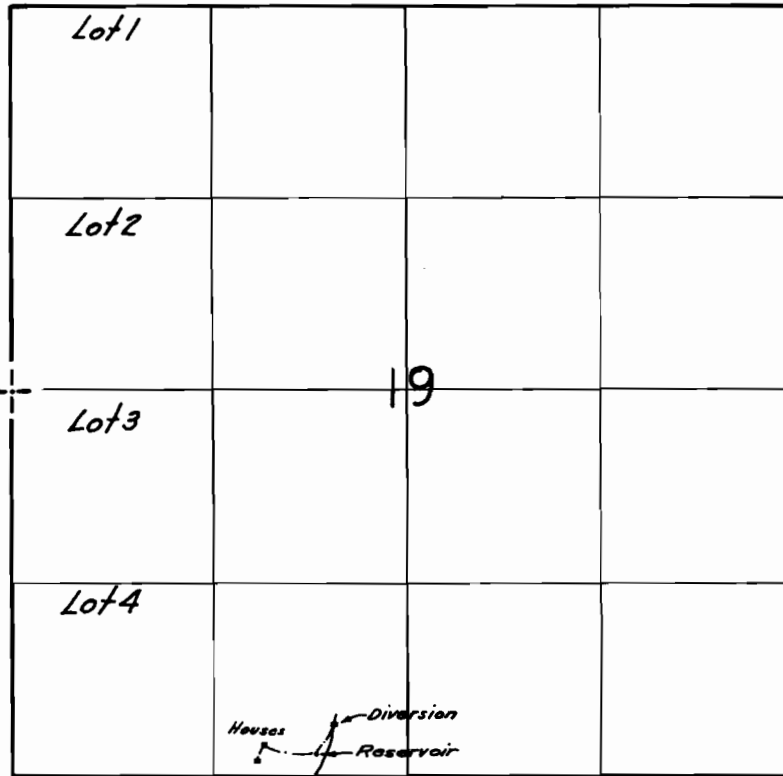

FINAL PROOF SURVEY

UNDER

Application No. 17057 Permit No. 12796

IN NAME OF

Robert M. Staysa

Surveyed Aug. 9, 1941, by [Signature]