


TOWNSHIP 4 S., RANGE 3 E.

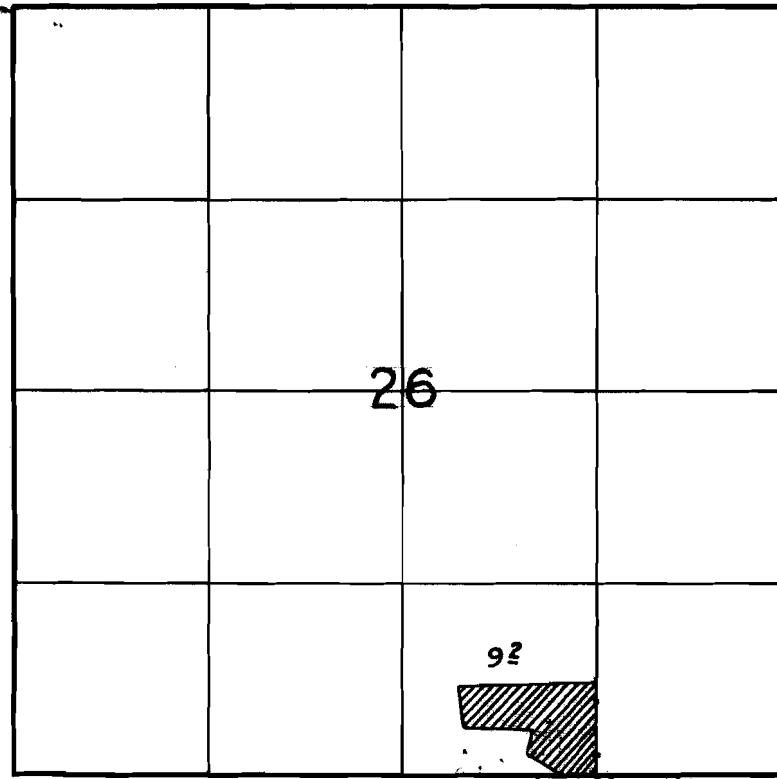

Intake

FINAL PROOF SURVEY

UNDER

Application No. 16943 Permit No. 12823

IN NAME OF

F. Lee Riffey

Surveyed May 22 1941, by W. L. Cummings