


TOWNSHIP 5 S RANGE 2 E.

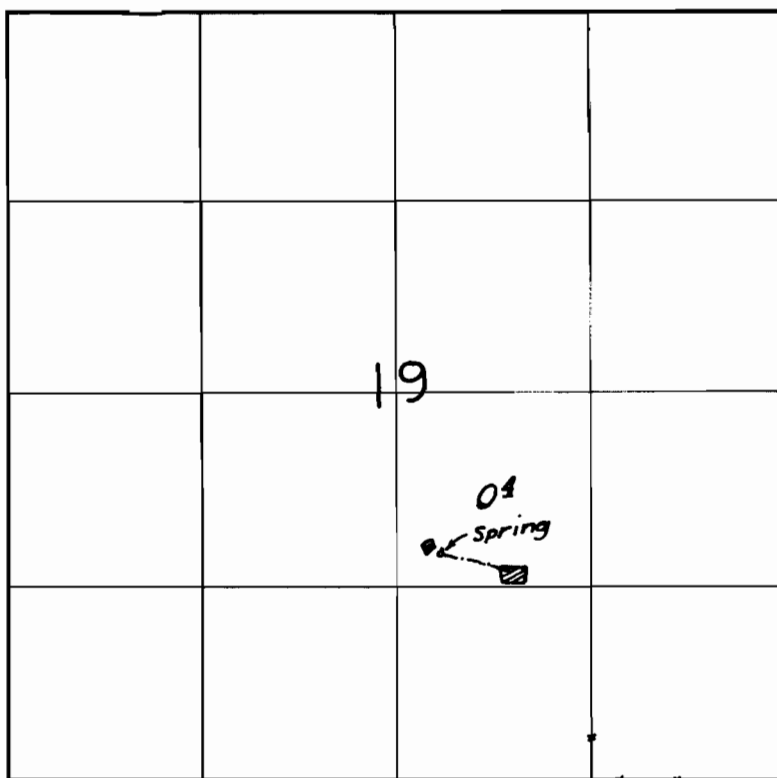

FINAL PROOF SURVEY
UNDER

Application No. 17146 Permit No. 12867

IN NAME OF

A. D. Wilkowske

Surveyed May 24 1941, by G. L. Hummings