


TOWNSHIP 19 S. RANGE 47 E.

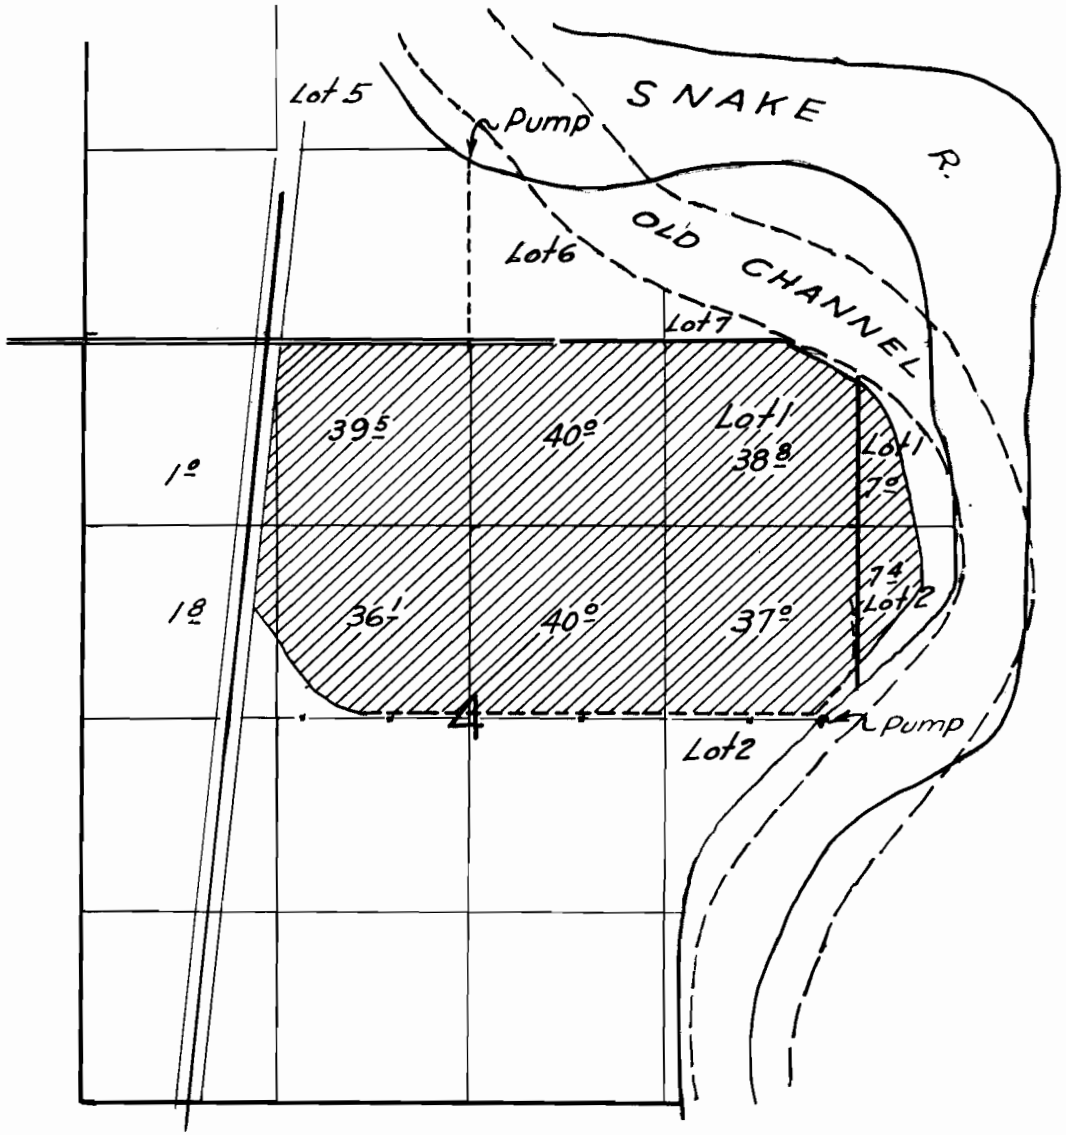

FINAL PROOF SURVEY

UNDER

Application No. 17197 Permit No. 12921

IN NAME OF

Tri-State Investment Co.

Surveyed July 25 1941, by Edw. L. Cummins