


TOWNSHIP 3 S. RANGE 3 W.

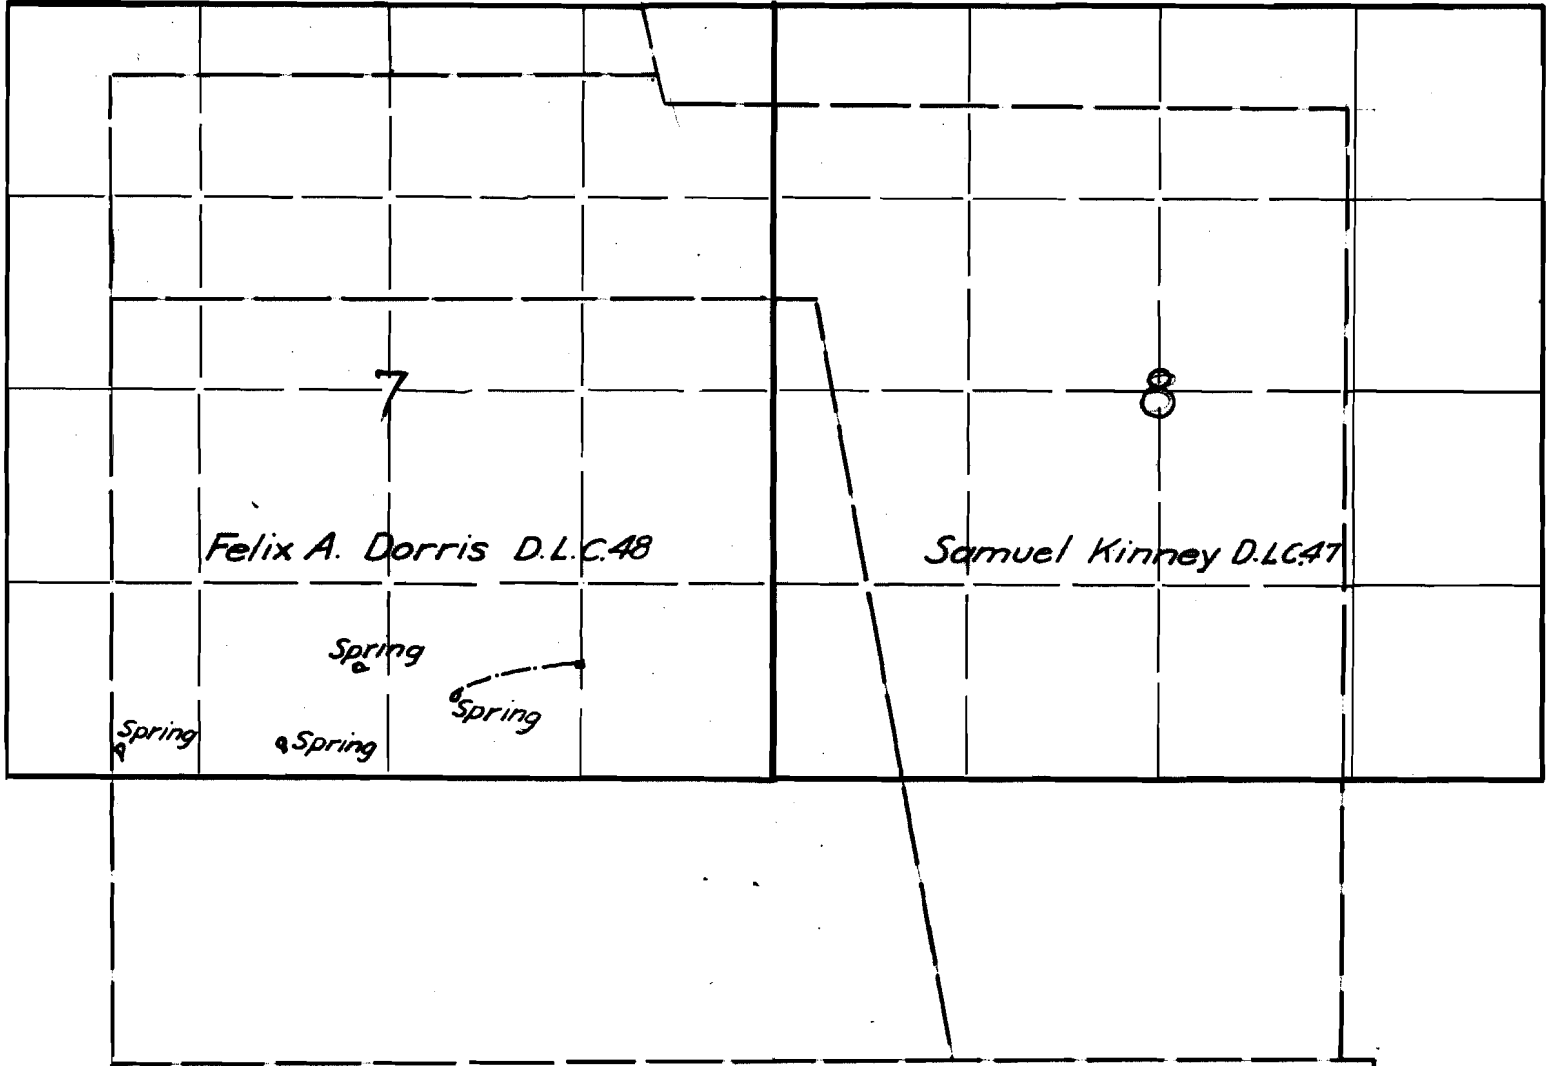

**FINAL PROOF SURVEY**  
UNDER

Application No. 17271 Permit No. 12981

IN NAME OF

E. C. Madsen

Surveyed Apr 29 1941, by E. C. Madsen