
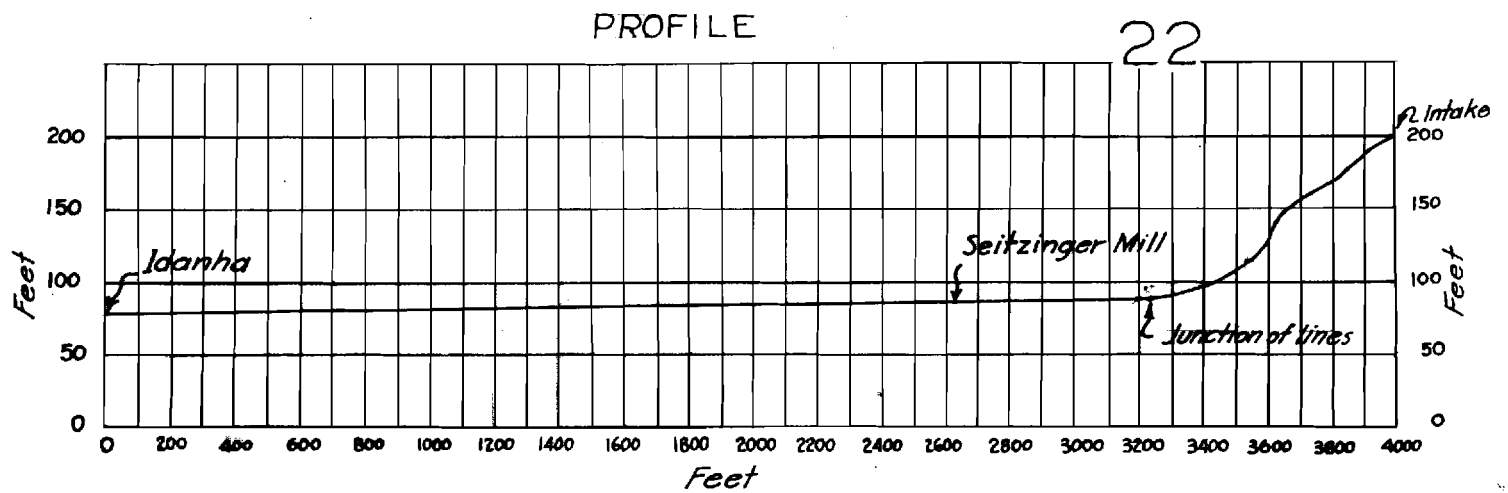


T. 10 S., R. 6 E.

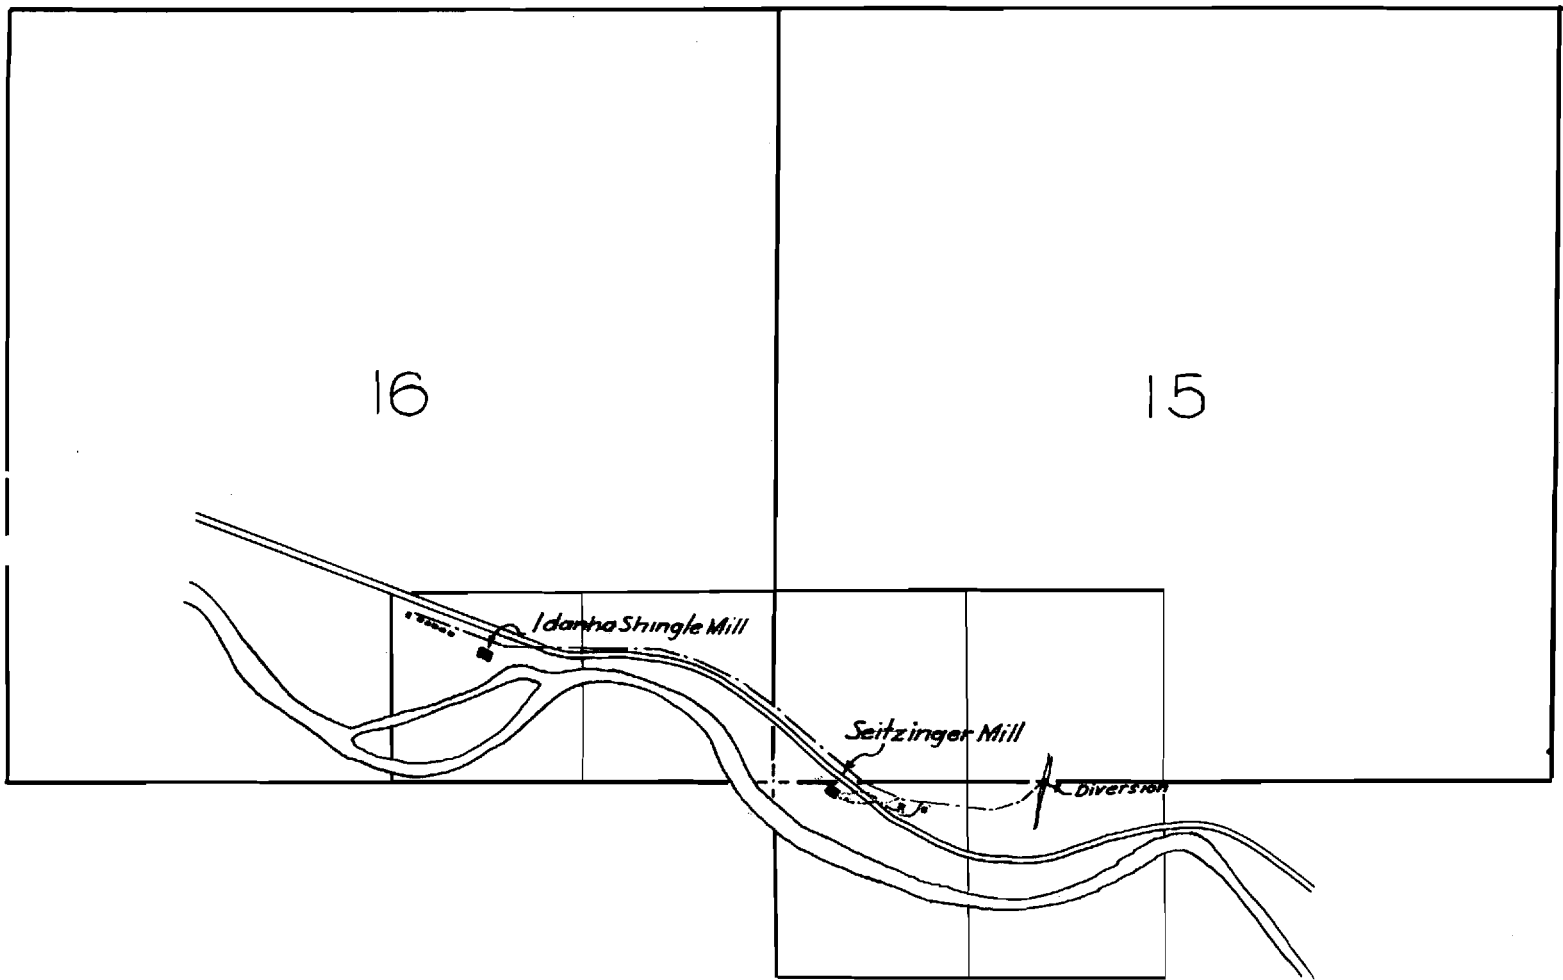

Surveyed July 1, 1941
Charles L. Cummings

App. 17272
App. 18707
Permit 12982
Permit 14330