


TOWNSHIP 10 S., RANGE 11 W.

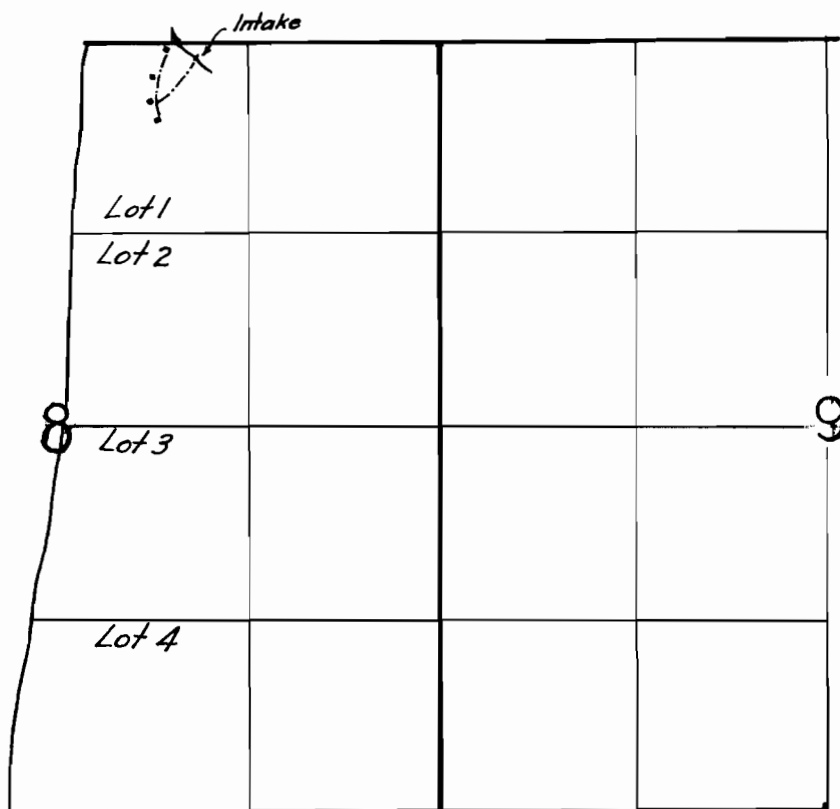

FINAL PROOF SURVEY
UNDER

Application No. 17296 Permit No. 13002

IN NAME OF

Joseph P. Boyd & V. R. Owens

Surveyed Aug. 7, 1941, by Ed Cumming